

STATE OF KANSAS
STATE CORPORATION COMMISSION


Give All Information Completely,
Make Required Affidavit
Mail or Deliver Report to:
Conservation Division
State Corporation Commission
211 No. Broadway
Wichita, Kansas

WELL PLUGGING RECORD

Ness County, Sec. 13 Twp. 17 Rge. 25 (X) W (W)

Location as "NE/CNW/SW" or footage from lines C, SE SE
Lease Owner E. K. Carey Drilling Co., Inc.
Lease Name R. H. Potter Well No. 1
Office Address Box 620, McPherson, Kansas
Character of Well (completed as Oil, Gas or Dry Hole) Dry hole
Date well completed March 2, 1958
Application for plugging filed March 1, 1958
Application for plugging approved March 1, 1958
Plugging commenced 10 P.M. March 1, 1958
Plugging completed 12.05 P.M. March 2, 1958
Reason for abandonment of well or producing formation Dry hole

NORTH

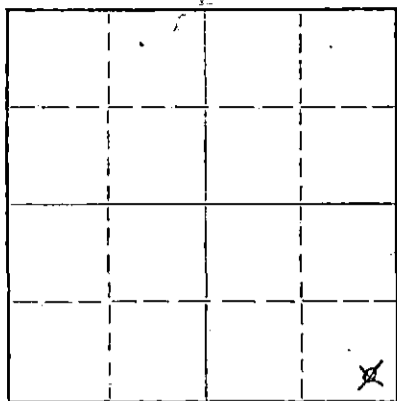

Locate well correctly on above
Section Plat

If a producing well is abandoned, date of last production _____ 19____
Was permission obtained from the Conservation Division or its agents before plugging was commenced? Yes

Name of Conservation Agent who supervised plugging of this well Gib Lieker, Victoria, Kansas
Producing formation _____ Depth to top _____ Bottom _____ Total Depth of Well 4423 Feet
Show depth and thickness of all water, oil and gas formations.

OIL, GAS OR WATER RECORDS

CASING RECORD

FORMATION	CONTENT	FROM	TO	SIZE	PUT IN	PULLED OUT
				8-5/8"	252	None

Describe in detail the manner in which the well was plugged, indicating where the mud fluid was placed and the method or methods used in introducing it into the hole. If cement or other plugs were used, state the character of same and depth placed, from 480-420 feet to 240-180 feet for each plug set.

Circulated heavy mud on bottom, layed down all but 480' of drill pipe, mixed 20 sacks cement and put thru drill pipe. Layed down all but 8 jts. drill pipe, ran measuring line and filled hole with heavy mud to 240', made bridge at 240' with plug and rock to hold weight of 8 jts. drill pipe. Mixed 20 sacks cement and put thru drill pipe. Layed down rest of drill pipe, ran measuring line and filled with heavy mud to 35'. Set plug at 35' and 1/2 sack hulls on top of plug, mixed 10 sacks cement and put on top of plug and filled to bottom of cellar floor. Through at 12.05 March 2, 1958.

(If additional description is necessary, use BACK of this sheet)

Name of Plugging Contractor E. K. Carey Contractor, Rig #1
Address Box 620, McPherson, Kansas

STATE OF Kansas, COUNTY OF McPherson, ss.
Arland Bruce, Superintendent (employee of owner) or (owner or operator) of the above-described well, being first duly sworn on oath, says: That I have knowledge of the facts, statements, and matters herein contained and the log of the above-described well as filed and that the same are true and correct. So help-me God.

(Signature) Arland Bruce
Box 620, McPherson, Kansas
(Address)

SUBSCRIBED AND SWORN to before me this 3rd day of March, 19 58

My commission expires November 13, 1960

Notary Public
STATE OF KANSAS

PLUGGING
FILE SEC 13 T. 17 R. 25
BOOK PAGE 81 LINE 2

MAR 4 1958
3-4-58
CONSULTING ENGINEER
Wichita, Kansas

ROTARY DRILLER'S LOG

15.135.00442.00.00

E. K. Carey Drilling Co., Inc.
Box 620
McPherson, Kansas

Elevation 2391 K.B.
2388 D.F.

R. H. Potter #1

Casing Record:

C, SE SE
Sec. 13-17S-25W,
Ness County, Kansas

8-5/8" @ 252' w/125 sks.
Pozmix cement and 2% cc.

Well Commenced: 2-14-1958
Well Completed: 3- 2-1958 D & A

Contractor: E. K. Carey Contractor, Rig #1, Box 620, McPherson, Kansas
Geologist: Ed. Sabatka, E. K. Carey Drlg. Co. 815 Central Bldg. Wichita

Figures Indicate Bottom of Formation K. B.

base and cellar	8
shale	194
shale and shells	252
shale and sand streaks	530
shale and sand	1025
sandy shale	1170
sand	1400
sand and shale	1450
shale	1700
lime	1730
shale and lime	1885
lime and shale	2065
shale and lime	2185
salt	2300
shale and lime	2355
lime and shale	2500
lime	3500
sandy lime	3533
lime	4395
conglomerate	4398
Miss.	4413
Miss lime	4423 TD

Geologist Tops:

Heebner	3748
Toronto	3770
Lansing K. C.	3792
Bs. K. C.	4091
Ft. Scott	4301
Miss.	4398

Rotary Total Depth 4423

DST - 4399-4413' or 14' anchor. Tool open with weak blow, flushed tool fair blow thru-out test. Closed 30 min. for BHP. Recovered 188' muddy salt water. BHP 1120#.

RECEIVED
STATE CORPORATION COMMISSION

MAR 4 1958

CONSERVATION DIVISION
Wichita, Kansas

This is to certify that the above information is to the best of my knowledge true and correct.

SUBSCRIBED AND SWORN to before me this 3rd day of March, 1958.

E. K. CAREY CONTRACTOR

BY Arland Bruce
Arland Bruce, Superintendent

Notary Public
Notary Public

My Commission Expires: November 13, 1960

PLUGGING
FILE SEC 13 T 17 R 25W
BOOK PAGE 87 LINE 2