

STATE OF KANSAS
STATE CORPORATION COMMISSION

WELL PLUGGING RECORD

Give All Information Completely
Make Required Affidavit
Mail or Deliver Report to
Conservation Division
State Corporation Comm.
245 North Water
Wichita, KS 67202

Ness County, Sec. 33 Twp. 17S Rge. 21W ~~EXX~~
Location as "NE/CNW $\frac{1}{4}$ /SW $\frac{1}{4}$ " or footage from lines
SE NW SW

Lease Owner Hummon Oil Company
Lease Name Casey Well No. 1
Office Address 1725 Vickers-KSB&T Bldg., Wichita, Ks.
Character of Well (Completed as Oil, Gas or Dry Hole)

Dry Hole


Date Well completed August 2, 1978
Application for plugging filed August 2, 1978
Application for plugging approved August 2, 1978
Plugging commenced August 2, 1978
Plugging completed August 2, 1978
Reason for abandonment of well or producing formation

Dry Hole

If a producing well is abandoned, date of last production 19

Was permission obtained from the Conservation Division or its agents before plugging was commenced? Yes

Name of Conservation Agent who supervised plugging of this well Leo F. Massey
Producing formation Depth to top Bottom Total Depth of Well 4213'
Show depth and thickness of all water, oil and gas formations.

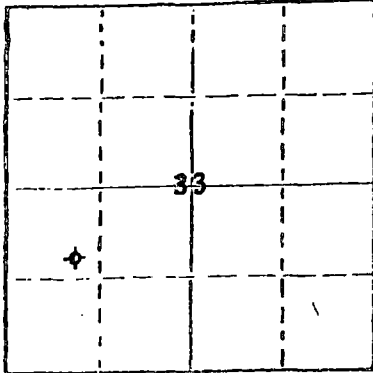

Locate well correctly on above Section Plat

OIL, GAS OR WATER RECORDS

CASING RECORD

FORMATION	CONTENT	FROM	TO	SIZE	PUT IN	PULLED OUT
		0'	383'	8-5/8"	375.02'	None

Describe in detail the manner in which the well was plugged, indicating where the mud fluid was placed and the method or methods used in introducing it into the hold. If cement or other plugs were used, state the character of same and depth placed, from feet to feet for each plug set.

Plugged with 70 sacks cement at 550',
20 sacks cement at 300', 10 sacks cement
with 1/2 sack hulls and plug at 40',
3 sacks cement in rat hole.

RECEIVED
STATE CORPORATION COMMISSION
AUG 14 1978

(If additional description is necessary, use BACK of this sheet)

Name of Plugging Contractor Allied Cementing Company

STATE OF KANSAS COUNTY OF SEDGWICK, ss.
John D. Knightley Agent (employee of owner) or (owner or operator)
of the above-described well, being first duly sworn on oath, says: That I have knowledge of the facts, statements, and matters herein contained and the log of the above-described well as filed and that the same are true and correct. So help me God.

(Signature)

221 S. Broadway, Wichita, Kansas 67202
(Address)

SUBSCRIBED AND SWORN TO before me this 10th day of August, 1978

Stella J. Lips Notary Public.

My commission expires March 12, 1979

Hummon Oil Company - Casey #1
 SE NW SW Sec. 33-17S-21W
 Ness County, Kansas

Contractor: D. R. Lauck Oil Company, Inc.
 221 S. Broadway, Suite 400
 Wichita, Kansas 67202

Commenced: July 24, 1978
 Completed: August 2, 1978

Drillers Log

Sand	385
Blue Shale	615
Red Bed	875
Sand	1010
Red Bed	1419
Shale	1438
Anhydrite	1456
Shale	1720
Shale & Shells	2490
Lime	2710
Shale & Shells	3145
Lime	3345
Shale & Lime	3585
Lime & Shale	4000
Lime	4213 RTD

RECEIVED
 STATE CONSERVATION COMMISSION

AUG 14 1978

CONSERVATION DIVISION
 Wichita, Kansas