

STATE OF KANSAS
STATE CORPORATION COMMISSION

Give All Information Completely
Make Required Affidavit
Mail or Deliver Report to:
Conservation Division
State Corporation Commission
211 No. Broadway,
Wichita, Kansas

WELL PLUGGING RECORD

NESS County. Sec. 15 Twp. 17S Rge. 21W (X) (W)

Location as "NE/CNW/SW" or footage from lines C SE NW

Lease Owner PETROLEUM, INC.

Lease Name ANDERSON "I" Well No. 1

Office Address ROUTE 2, GREAT BEND, KANSAS

Character of Well (completed as Oil, Gas or Dry Hole) DRY HOLE

Date well completed 11-7 19 62

Application for plugging filed 11-7 19 62

Application for plugging approved 11-7 19 62


Plugging commenced 11-7 19 62

Plugging completed 11-7 19 62

Reason for abandonment of well or producing formation NO PRODUCIBLE FORMATIONS

If a producing well is abandoned, date of last production NONE 19

Was permission obtained from the Conservation Division or its agents before plugging was commenced? YES

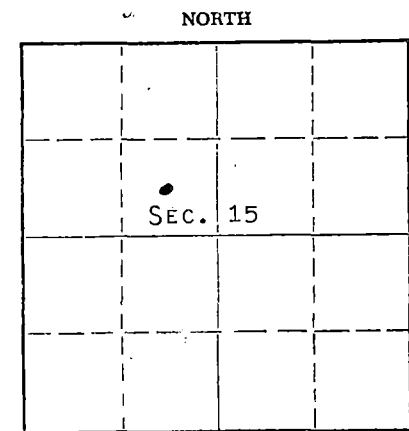

Locate well correctly on above Section Plat

Name of Conservation Agent who supervised plugging of this well ELDON PETTY

Producing formation - - - Depth to top - - Bottom - - Total Depth of Well 4300 Feet

Show depth and thickness of all water, oil and gas formations.

OIL, GAS OR WATER RECORDS

CASING RECORD

FORMATION	CONTENT	FROM	TO	SIZE	PUT IN	PULLED OUT
				8-5/8"	244'	NONE

Describe in detail the manner in which the well was plugged, indicating where the mud fluid was placed and the method or methods used in introducing it into the hole. If cement or other plugs were used, state the character of same and depth placed, from feet to feet for each plug set.

MUDDED UP WITH HEAVY MUD TO 550', FOLLOWED BY WOODEN PLUG, PLACED 20 SACKS CEMENT THROUGH DRILL PIPE ON TO PLUG. MUDDED UP WITH HEAVY MUD TO 180' FOLLOWED BY WODDEN PLUG. PLACED 15 SACKS CEMENT THROUGH DRILL PIPE ONTO PLUG. MUDDED UP WITH HEAVY MUD TO 40' FOLLOWED BY 10 SACKS CEMENT TO BASE OF WELL CELLAR.

RECEIVED
STATE CORPORATION COMMISSION
NOV 21 1962
CONSERVATION DIVISION
Wichita, Kansas

(If additional description is necessary, use BACK of this sheet)

Name of Plugging Contractor RAINS & WILLIAMSON OIL CO.
Address 412 UNION CENTER, WICHITA 2, KANSAS

STATE OF KANSAS, COUNTY OF BARTON, ss.
DON SEARLE (employee of owner) or (owner) of the above-described

well, being first duly sworn on oath, says: That I have knowledge of the facts, statements, and matters herein contained and the log of the above-described well as filed and that the same are true and correct. So help me God.

(Signature) Don Searle
DON SEARLE, DIST. PROD. SUPT.

(Address)

SUBSCRIBED AND SWORN TO before me this 19TH day of NOVEMBER, 1962

My commission expires APRIL 14, 1963. Notary Public.



ROTARY DRILLING LOG

OPERATOR: Petroleum, Inc.
 NO. 1 ANDERSON
 C SE NW of Sec. 15-17S-21W
 Ness County, Kansas

CONTRACTOR: Rains & Williamson Oil Co
 COMM: 10-27-62
 COMP: 11-7-62

Remarks: Set 8-5/8" surface casing
 at 244' with 200 sacks
 Common Globe cement

Formations:

Clay	55'
Shale and Shells	350'
Sand	375'
Shale and Shells	455'
Shale and Red Bed	545'
Shale and Shells	775'
Red Bed	930'
Sand and Red Bed	1220'
Red Bed and Shale	1350'
Shale and Shells	1470'
Anhydrite	1515'
Shale and Shells	2200'
Lime and Shale Breaks	2330'
Lime	2575'
Shale and Shells	2635'
Lime and Shale	2935'
Shale and Shells	3040'
Shale and Lime	3255'
Lime and Shale	3340'
Lime and Shale w/Chalk Streaks	3460'
Lime and Shale	3630'
Lime	3820'
Lime and Shale	3866'
Lime	4000'
Lime and Shale	4095'
Lime	4220'
Lime and Chert	4300'
Rotary Total Depth (D & A)	4300'

RECEIVED
 STATE CORPORATION COMMISSION

NOV 21 1962

CONSERVATION DIVISION
 Wichita, Kansas

We certify the above log is true
 and correct to the best of our
 knowledge and belief.

RAINS & WILLIAMSON OIL CO.

Wilson Rains
 Wilson Rains
 Partner

Subscribed and sworn to before me, a
 Notary Public in and for the State of
 Kansas, County of Sedgwick, this 9th
 day of November, 1962.

Sandra Anos
 Sandra Anos

My Commission Expires: August 14, 1966