

STATE OF KANSAS
STATE CORPORATION COMMISSION

WELL PLUGGING RECORD

Give All Information Completely
Make Required Affidavit
Mail or Deliver Report to
Conservation Division
State Corporation Comm.
245 North Water
Wichita, KS 67202

Ness County, Sec. 3 Twp. 17S Rge. 21 ~~E~~/W
Location as "NE/CNW $\frac{1}{2}$ SW $\frac{1}{2}$ " or footage from lines
N/2 NW SW

Lease Owner Pendleton Land & Exploration
Lease Name Thompson Well No. #1
Office Address 1410 Security Life Bldg., Denver, Colorado 80202
Character of Well (Completed as Oil, Gas or Dry Hole)

Dry Hole

Date Well completed 4-13-80 19
Application for plugging filed 4-13-80 19
Application for plugging approved 4-13-80 19
Plugging commenced 4-13-80 19
Plugging completed 4-13-80 19


Reason for abandonment of well or producing formation
Commercial quantities of oil not found

If a producing well is abandoned, date of last production 19

Was permission obtained from the Conservation Division or its agents before plugging was commenced? Yes

Name of Conservation Agent who supervised plugging of this well Marion Schmidt
Producing formation Depth to top Bottom Total Depth of Well 4200'

Show depth and thickness of all water, oil and gas formations.

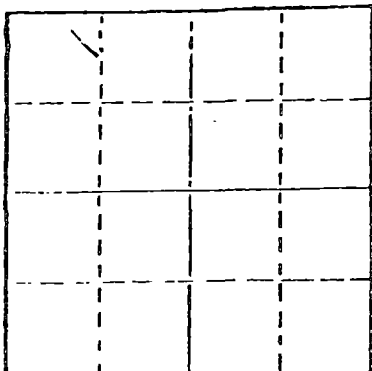

Locate well correctly on above Section Plat

OIL, GAS OR WATER RECORDS

CASING RECORD

FORMATION	CONTENT	FROM	TO	SIZE	PUT IN	PULLED OUT
				8 5/8"	366'	None

Describe in detail the manner in which the well was plugged, indicating where the mud fluid was placed and the method or methods used in introducing it into the hold. If cement or other plugs were used, state the character of same and depth placed, from feet to feet for each plug set.

Plug @ 700' w/70 sx.

Plug @ 300' w/20 sx.

Plug @ 10' w/10 sx.

Rat Hole 5 sx.

FEB 19 1981

CONSERVATION DIVISION
Wichita, Kansas

(If additional description is necessary, use BACK of this sheet)

Name of Plugging Contractor Buffalo Drilling Company, Inc.

STATE OF Kansas COUNTY OF Sedgwick, ss.

Jerald W. Rains, President of Buffalo Drilling Company, Inc. (employee of owner) or (owner or operator) of the above-described well, being first duly sworn on oath, says: That I have knowledge of the facts, statements, and matters herein contained and the log of the above-described well as filed and that the same are true and correct. So help me God.

(Signature)

Jerald W. Rains

435 Page Court, 220 W. Douglas, Wichita, Kansas 67202
(Address)

SUBSCRIBED AND SWORN TO before me this 16 day of April, 19 80

My commission expires

10-4-83

Juanita M. Green
Juanita M. Green Notary Public.



DRILLER'S LOG

COMPANY: Pendleton Land & Exploration

SEC. 3 T. 17S R. 21W

WELL NAME: Thompson #1

LOC. N/2 NW SW

COUNTY: Ness

RIG NO. #7

TOTAL DEPTH 4200'

ELEVATION

COMMENCED: 4-5-80

COMPLETED: 4-13-80

CONTRACTOR: Buffalo Drilling Company, Inc.

CASING RECORD:

SURFACE: 8 5/8" @ 366' w/200 sx. 60/40 poz., 2% gel, 3% cc.

PRODUCTION: D&A

LOG

(Figures Indicate Bottom of Formations)

Sand & Shale	1457
Shale	1718
Shale & Lime	2283
Lime & Shale	2380
Shale	2600
Shale & Lime	2850
Lime & Shale	4035
Lime	4200
<u>ROTARY TOTAL DEPTH</u>	<u>4200</u>

RECEIVED
STATE OF KANSAS COMMISSION

FEB 19 1981

CONSERVATION DIVISION
Wichita, Kansas

STATE OF Kansas)

COUNTY OF Sedgwick)


SS:

I, Jerald W. Rains, President of Buffalo Drilling Company, Inc.

upon oath state that the above and foregoing is a true and correct copy of the log of the

Thompson #1 well.

Jerald W. Rains
Jerald W. Rains

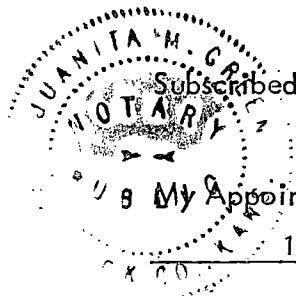

Subscribed and sworn to before me this 16 day of April, 1980.

My Appointment Expires:
10-4-83

Juanita M. Green
Juanita M. Green