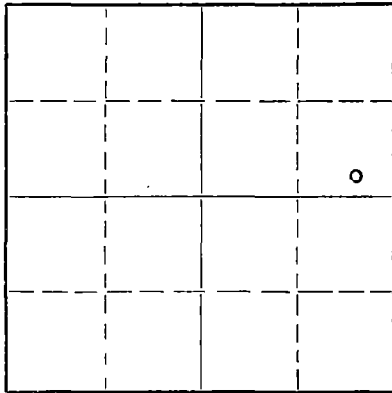


STATE OF KANSAS
STATE CORPORATION COMMISSION

Give All Information Completely
Make Required Affidavit
Mail or Deliver Report to:
Conservation Division
State Corporation Commission
800 Bittling Building
Wichita, Kansas

WELL PLUGGING RECORD

NORTH

Locate well correctly on above
Section PlatBartonCounty. Sec. 4 Twp. 20 Rge. 15 (E) (W)Location as "NE/CNW/SW" or footage from lines SE SE NE 330 from EastLease Owner Schermerhorn Oil Corp. 330 " South lineLease Name Nairn Well No. _____Office Address 714 Nat. Bank Bldg., Tulsa, Okla.Character of Well (completed as Oil, Gas or Dry Hole) DryDate well completed 3-30 19 53Application for plugging filed 3-30 19 53Application for plugging approved 3-30 19 53Plugging commenced 3-30 19 53Plugging completed 4-1 19 53Reason for abandonment of well or producing formation Dry

If a producing well is abandoned, date of last production _____ 19 _____

Was permission obtained from the Conservation Division or its agents before plugging was commenced? YesName of Conservation Agent who supervised plugging of this well C. D. StoughProducing formation _____ Depth to top _____ Bottom _____ Total Depth of Well 3740 Feet

Show depth and thickness of all water, oil and gas formations.

OIL, GAS OR WATER RECORDS

CASING RECORD

FORMATION	CONTENT	FROM	TO	SIZE	PUT IN	PULLED OUT
		<u>0</u>	<u>945</u>	<u>8-5/8"</u>	<u>Cemented</u>	

Describe in detail the manner in which the well was plugged, indicating where the mud fluid was placed and the method or methods used in introducing it into the hole. If cement or other plugs were used, state the character of same and depth placed, from _____ feet to _____ feet for each plug set.

3740 to 950 Mud950 to 904 Cement904 to 300 Mud300 to Bottom cellar cement

(If additional description is necessary, use BACK of this sheet)

Name of Plugging Contractor Badger Drillers, Inc.Address Tulsa, OklahomaSTATE OF OKLAHOMA, COUNTY OF TULSA, ss.

_____, (employee of owner) or (owner or operator) of the above-described well, being first duly sworn on oath, says: That I have knowledge of the facts, statements, and matters herein contained and the log of the above-described well as filed and that the same are true and correct. So help me God.

(Signature) (Signed) Ola Williams

This is a true certified copy.


Albert, Kansas

(Address)

SUBSCRIBED AND SWORN TO before me this 15th day of April, 19 53My commission expires January 7, 1956.

Notary Public.

24-2675-S 2-52-20M

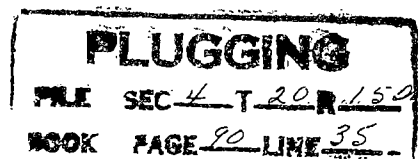

J. L. NAIRN #1
SE-SE-NE Sec. 4-20S-15W
Barton CO., Kansas

8 5/8" Casing cemented at 944'

Drilling started 3-17-53
Drilling completed 3-30-53

<u>FROM</u>	<u>TO</u>	<u>FORMATION</u>	<u>REMARKS</u>
0	40	Clay, sand	
40	300	Shale, sand	
300	345	Shale	
345	460	Sand, shale	
460	930	Red bed	
930	960	Anhydrite	8 5/8" O. D. Casing set @ 944'
960	1380	Shale & shells	w/400 sacks cement
1380	2995	Shale & lime	
2995	3740 T.D.	Lime	D. & A.

This is a certified true copy of the Driller's Log
as shown on the Drilling Reports.

BADGER DRILLERS, INC.

By: Don J. Jankins

Subscribed and sworn to before me this 15th day
of April, 1953.

My commission expires Jan. 7, 1956

Eva M. Davis
Notary Public

RECEIVED
STATE CORPORATION COMMISSION

APR 16 1953
CONSERVATION DIVISION
Wichita, Kansas

PLUGGING

FILE SEC 4 T 20 R 1524

BOOK PAGE 90 LINE 35