


STATE OF KANSAS  
STATE CORPORATION COMMISSION

WELL PLUGGING RECORD

Give All Information Completely  
Make Required Affidavit  
Mail or Deliver Report to:  
Conservation Division  
State Corporation Commission  
211 No. Broadway  
Wichita, Kansas

Barton County. Sec. 12 Twp. 20S Rge. 14W (D) (W)  
Location as "NE/CNW/SW" or footage from lines. SW 1/4 SE 1/4 SE 1/4  
Lease Owner R.S.C. Oil Co. & Leben Drilling, Inc.  
Lease Name Stolz "A" Well No. 1  
Office Address 905 Central Bldg., Wichita, Kansas  
Character of Well (completed as Oil, Gas or Dry Hole) Dry Hole  
Date well completed 12-19-57 19\_\_\_\_  
Application for plugging filed 12-19-57 19\_\_\_\_  
Application for plugging approved 12-19-57 19\_\_\_\_  
Plugging commenced 12-19-57 19\_\_\_\_  
Plugging completed 12-19-57 19\_\_\_\_  
Reason for abandonment of well or producing formation Dry Hole

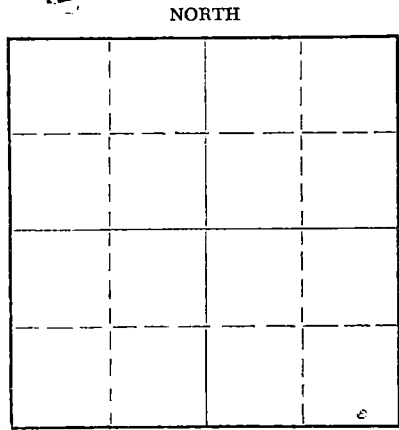

Locate well correctly on above Section Plat

If a producing well is abandoned, date of last production \_\_\_\_\_ 19\_\_\_\_  
Was permission obtained from the Conservation Division or its agents before plugging was commenced? yes

Name of Conservation Agent who supervised plugging of this well Eldon Petty  
Producing formation \_\_\_\_\_ Depth to top \_\_\_\_\_ Bottom \_\_\_\_\_ Total Depth of Well \_\_\_\_\_ Feet  
Show depth and thickness of all water, oil and gas formations.

OIL, GAS OR WATER RECORDS

CASING RECORD

FORMATION	CONTENT	FROM	TO	SIZE	PUT IN	PULLED OUT
				8 5/8"	803'	

Describe in detail the manner in which the well was plugged, indicating where the mud fluid was placed and the method or methods used in introducing it into the hole. If cement or other plugs were used, state the character of same and depth placed, from \_\_\_\_\_ feet to \_\_\_\_\_ feet for each plug set.

1st plug @ 300' w/20 sacks cement  
top plug @ 40' w/10 sacks cement to base of cellar.

RECEIVED  
CONSERVATION COMMISSION  
3-6-58  
MAR 6 1958  
CONSERVATION DIVISION  
Wichita, Kansas

(If additional description is necessary, use BACK of this sheet)  
Name of Plugging Contractor Leben Drilling, Inc.  
Address 905 Central Bldg., Wichita, Kansas

STATE OF Kansas, COUNTY OF Sedgwick, ss.  
I, Frank Hamlin (employee of owner) or (owner or operator) of the above-described well, being first duly sworn on oath, says: That I have knowledge of the facts, statements, and matters herein contained and the log of the above-described well as filed and that the same are true and correct. So help me God.

(Signature) Frank Hamlin  
905 Central Bldg., Wichita, Kansas  
(Address)

SUBSCRIBED AND SWORN to before me this 23rd day of December, 19 57

My commission expires June 17, 1961  
Ruth N. Benjamin Notary Public.

PLUGGING  
FILE SEC 12 T. 20 R. 14W  
BOOK PAGE 71 LINE 15

DRILLER'S LOG

COMPANY:  
CONTRACTOR:  
FAIR:  
LOCATION:

LEBEN DRILLING, INC. & R. S. C. OIL CO.  
LEBEN DRILLING, INC.  
STOLE "A" #1  
SW 1/4 SE 1/4 SE 1/4 340. 12-20S-14W  
BARTON COUNTY, KANSAS  
12-8-57  
12-19-57

COMMENCED:  
COMPLETED:

0	30	Surface Clay & Sand	
30	140	Sand	
140	305	Shale, Shells, & Sand	
305	390	Shale, Shells, & Sand	
390	620	Shale, Red Bed, & Sand	
620	791	Red Bed	
791	799	Anhydrite	TOPS:
799	810	Anhydrite	ANHYDRITE 793
810	1150	Shale & Lime Strs.	MEMBER 3131
1150	1675	Shale & Shells	TORONTO 3146
1675	1710	Shale	DOUGLAS 3158
1710	1985	Lime & Shale	DR. LIME 3239
1985	2380	Lime	LANSING 3251
2380	2520	Shale & Shells	
2520	2725	Shale	
2725	2975	Shale & Lime	ELEVATION 1882 K. B.
2975	3165	Lime	
3165	3235	Shale & Lime	
3235	3414	Lime	
3414	3426	Lime	
	3426	Rotary Total Depth - D. & A.	

Set 803' of 8 5/8" surface casing with 425 sacks cement, 3% CaCl, 5 sacks gel.

I, Frank Hamlin, do hereby certify that the above and foregoing is a true and correct copy of the log of the Stolz "A" #1, located SW 1/4, SE 1/4, SE 1/4, of Section 12, Township 20 South, Range 14 West, Barton County, Kansas as reflected by the files of Leben Drilling, Inc.

RECEIVED  
STATE CORPORATION COMMISSION

LEBEN DRILLING, INC.

MAR 6 1958

By:

CONSERVATION DIVISION  
Wichita, Kansas

*Frank Hamlin*  
Frank Hamlin

STATE OF KANSAS )  
COUNTY OF SEDGWICK ) SS

Subscribed and sworn to before me, a Notary Public, in and for Sedgwick County, Kansas, this 30th day of January, 1958.

*Ruth N. Benjamin*  
Ruth N. Benjamin, Notary Public

My Commission Expires:  
June 17, 1961.

PLUGGING  
FILE SEC 12 T 20 R 14W  
BOOK PAGE 71 LIME 15