


WELL PLUGGING RECORD

Give All Information Completely  
Make Required Affidavit  
Mail or Deliver Report to:  
Conservation Division  
State Corporation Commission  
211 No. Broadway  
Wichita, Kansas

PAWNEE County, Sec. 8 Twp. 20S Rge. 16W (X) (W)

Location as "NE/CNW $\frac{1}{4}$ SW $\frac{1}{4}$ " or footage from lines NW SW SE  
Lease Owner PETROLEUM, INC.  
Lease Name FLESKE Well No. 1  
Office Address ROUTE 2, GREAT BEND, KANSAS  
Character of Well (completed as Oil, Gas or Dry Hole) DRY HOLE  
Date well completed OCTOBER 20, 19 62  
Application for plugging filed OCTOBER 20 19 62  
Application for plugging approved OCTOBER 20 19 62  
Plugging commenced OCTOBER 20 19 62  
Plugging completed OCTOBER 20 19 62  
Reason for abandonment of well or producing formation NO PRODUCING FORMATIONS.

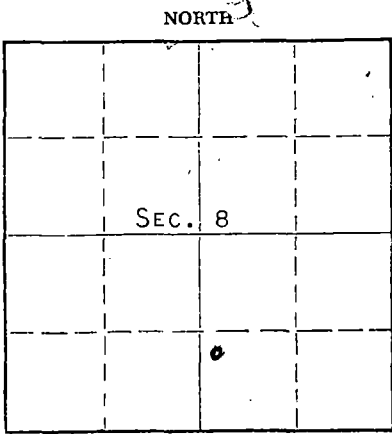

Locate well correctly on above Section Plat

If a producing well is abandoned, date of last production NONE 19  
Was permission obtained from the Conservation Division or its agents before plugging was commenced? YES

Name of Conservation Agent who supervised plugging of this well W. L. LACKAMP  
Producing formation - - - Depth to top - Bottom - Total Depth of Well 3841 Feet  
Show depth and thickness of all water, oil and gas formations.

OIL, GAS OR WATER RECORDS				CASING RECORD		
FORMATION	CONTENT	FROM	TO	SIZE	PUT IN	PULLED OUT
				8-5/8"	1118'	NONE

Describe in detail the manner in which the well was plugged, indicating where the mud fluid was placed and the method or methods used in introducing it into the hole. If cement or other plugs were used, state the character of same and depth placed, from feet to feet for each plug set.

MUDDED UP WITH HEAVY MUD TO 300', FOLLOWED BY WOODEN PLUG. PLACED 20 SACKS CEMENT THROUGH DRILL PIPE ON TO PLUG. MUDDED UP WITH HEAVY MUD TO 35' FOLLOWED BY WOODEN PLUG, 1/4 SACK HULLS AND 10 SACKS CEMENT TO BASE OF WELL CELLAR.

RECEIVED  
STATE CORPORATION COMMISSION

NOV 21 1962

CONSERVATION DIVISION  
Wichita, Kansas

11-21-62

(If additional description is necessary, use BACK of this sheet)  
Name of Plugging Contractor GARVEY DRILLING COMPANY  
Address ROUTE 2, GREAT BEND, KANSAS

STATE OF KANSAS, COUNTY OF BARTON, ss.  
DON SEARLE (employee of owner) or (owner) of the above-described well, being first duly sworn on oath, says: That I have knowledge of the facts, statements, and matters herein contained and the log of the above-described well as filed and that the same are true and correct. So help me God.

(Signature) Don Searle  
DON SEARLE, DIST. PROD. SUPT.  
ROUTE 2, GREAT BEND, KANSAS  
(Address)

SUBSCRIBED AND SWORN to before me this 19TH day of NOVEMBER, 19 62

My commission expires APRIL 14, 1963.

Cooper J. Miles  
Notary Public.



# WELL LOG

15.145.00501.0000

COMPANY PETROLEUM, INCORPORATED

SEC. 8 T. 20S R. 16W

FARM FLESKE NO. 1

LOC. Approx. NW, SW, SE


TOTAL DEPTH 3841'

COUNTY PAWNEE CO., KANSAS

COMM. October 11, 1962 COMP. October 20, 1962

CONTRACTOR GARVEY DRILLING COMPANY

CASING 8-5/8" @ 1118' w/500 sax.

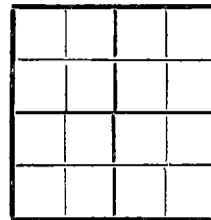

ELEVATION 2071' D.F.

PRODUCTION D & A

FIGURES INDICATE BOTTOM OF FORMATIONS

40	Post rock & clay
515	Shale
645	Sand & shale
1112	Red bed
1146	Anhydrite
1730	Shale
1850	Shale & lime
2230	Lime
2480	Lime & shale
2590	Lime
2800	Shale & lime
3120	Lime & shale
3227	Shale & lime
3265	Shale
3545	Lime & shale
3801	Lime
3824	Conglomerate
3841	Lime
3841	T. D.

RECEIVED  
STATE CORPORATION COMMISSION  
NOV 21 1962  
CONSERVATION DIVISION  
Wichita, Kansas

State of KANSAS }  
County of BARTON } SS

I, VERNE A. MORRIS of GARVEY DRILLING COMPANY

upon oath state the above and foregoing is a true and correct copy of the log of the #1 FLESKE well.

*Verne A. Morris*

Subscribed and sworn to before me this 16th day of November 19 62

My Commission Expires: April 14, 1963

*Arthur J. Miller*  
NOTARY PUBLIC