

STATE OF KANSAS
STATE CORPORATION COMMISSION


WELL PLUGGING RECORD

Give All Information Completely
Make Required Affidavit
Mail or Deliver Report to:
Conservation Division
State Corporation Commission
800 Bitting Building
Wichita, Kansas

OR
FORMATION PLUGGING RECORD

Strike out upper line
when reporting plug-
ging off formations.

NORTH

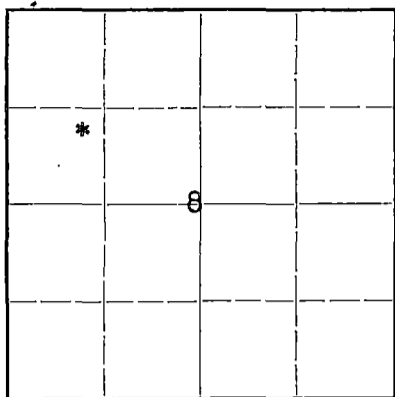

Locate well correctly on above
Section Plat

Pawnee County. Sec. 8 Twp 20S Rge. (E) 16 (W)
Location as "NE 1/4 NW 1/4 SW 1/4" or footage from lines. NE SW NW
Lease Owner. Magnolia Petroleum Company
Lease Name. Lucy Rutherford "A" Well No. 1
Office Address. RFD 1, Ellinwood, Kansas
Character of Well (completed as Oil, Gas or Dry Hole). Dry Hole
Date well completed. August 13, 1946. 19.
Application for plugging filed. By telephone 8/13/46 19.
Application for plugging approved. by telephone 8/13/46 19.
Plugging commenced. August 13, 1946. 19.
Plugging completed. August 13, 1946. 19.
Reason for abandonment of well or producing formation. Dry Hole


If a producing well is abandoned, date of last production. 19.
Was permission obtained from the Conservation Division or its agents before plugging was com-
menced? Yes

Name of Conservation Agent who supervised plugging of this well. Mr. Kerr, Great Bend, Kansas
Producing formation. Depth to top. Bottom. Total Depth of Well. 3879 Feet
Show depth and thickness of all water, oil and gas formations.

OIL, GAS OR WATER RECORDS

CASING RECORD

Formation	Content	From	To	Size	Put In	Pulled Out
Arbuckle Lime	No Oil	3877	3879	8-5/8"	1166	None

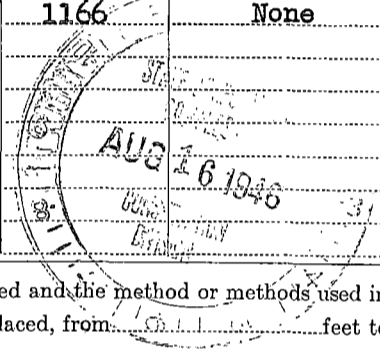

Describe in detail the manner in which the well was plugged, indicating where the mud fluid was placed and the method or methods used in introducing it into the hold. If cement or other plugs were used, state the character of same and depth placed, from feet to feet for each plug set.

Filled with 25 Sax. cement thru drill pipe by HOWCO. from 3879 to 3774.
Filled with heavy mud thru drill pipe from 3774 to 22'
Filled with 5 Sax cement thru drill pipe from 22' to 6' or bottom of cellar.
Filled cellar with soil to ground level.

8 20 1644
66 24

(If additional description is necessary, use BACK of this sheet)

Correspondence regarding this well should be addressed to Magnolia Petroleum Company
Address. RFD 1, Ellinwood, Kansas

STATE OF Kansas, COUNTY OF Barton, ss.
C. A. Hill (employee of owner) or (owner or operator) of the above-described well,

being first duly sworn on oath, says: That I have knowledge of the facts, statements, and matters herein contained and the log of the above-described well as filed and that the same are true and correct. So help me God.

(Signature) [Signature]

RFD 1, Ellinwood, Kansas
(Address)

SUBSCRIBED AND SWORN to before me this 15th day of August, 1946

[Signature] Notary Public.

My commission expires November 30, 1949

MAGNOLIA PETROLEUM COMPANY
 Lucy Rutherford "A" #1
 NE SW NW Sec. 8-T20S-R16W
 Pawnee County, Kansas

Drilling Commenced: 7/26/46
 Drilling Completed: 8/13/46

Casing Record:
 Set 1166' of 8-5/8" Csg. -Cem. 475 Sax.

Clay	0	150
shale	150	270
red bed	270	315
sand	315	365
shale	365	450
sand	450	500
shale	500	540
sand	540	695
shale	695	735
shale & shells	735	1040
red bed	1040	1161
Top Anhydrite	1160	
Anhydrite	1161	1186
8-5/8" Csg. set	1166	
shale & shells	1186	1545
lime & shale	1545	1761
broken lime	1761	1935
shale & shells	1935	2030
lime & shale	2030	2115
broken lime	2115	2245
lime & shale	2245	2360
broken lime	2360	2780
lime & shale	2780	2980
broken lime	2980	3065
lime & shale	3065	3125
lime	3125	3195
lime & shale	3195	3445
broken lime	3445	3530
shale & lime shells	3530	3625
lime	3625	3810
lime & shale	3810	3879
Top Arbuckle	3877	
No Oil Shows		
TD:SLM	3879	

D and A.

8 20 16W
 66 24