


STATE OF KANSAS  
STATE CORPORATION COMMISSION  
CONSERVATION DIVISION  
P. O. BOX 17027  
WICHITA, KANSAS 67217

FORM CP-4

WELL PLUGGING RECORD

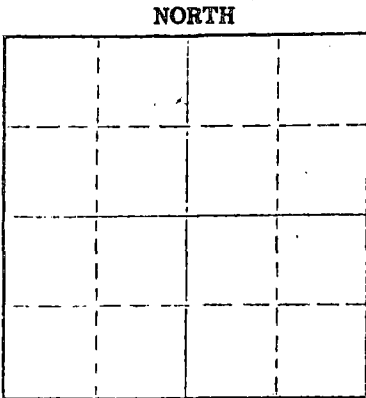

Locate well correctly on above Section Plot

Pawnee County. Sec. 7 Twp. 20 Rge. 16 (E) (W)  
Location as "NE/CNW/SW" or footage from lines. 150' N. of NW SE-SE  
Lease Owner Emphasis Oil Operators  
Lease Name Russell #1 Well No. \_\_\_\_\_  
Office Address Russell, Kansas 67665  
Character of Well (completed as Oil, Gas or Dry Hole) \_\_\_\_\_  
Date well completed \_\_\_\_\_ 19\_\_\_\_  
Application for plugging filed \_\_\_\_\_ 19\_\_\_\_  
Application for plugging approved \_\_\_\_\_ 19\_\_\_\_  
Plugging commenced 11/17/75 \_\_\_\_\_ 19\_\_\_\_  
Plugging completed 11/24/75 \_\_\_\_\_ 19\_\_\_\_  
Reason for abandonment of well or producing formation depleted.

If a producing well is abandoned, date of last production \_\_\_\_\_ 19\_\_\_\_  
Was permission obtained from the Conservation Division or its agents before plugging was commenced? yes

Name of Conservation Agent who supervised plugging of this well Massey  
Producing formation \_\_\_\_\_ Depth to top \_\_\_\_\_ Bottom \_\_\_\_\_ Total Depth of Well 3842 feet  
Show depth and thickness of all water, oil and gas formations.

OIL, GAS OR WATER RECORDS

CASING RECORD

FORMATION	CONTENT	FROM	TO	SIZE	PUT IN	PULLED OUT
				8-5/8	248	none
				5 1/2"	3808	2348'

Describe in detail the manner in which the well was plugged, indicating where the mud fluid was placed and the method or methods used in introducing it into the hole. If cement or other plugs were used, state the character of same and depth placed, from \_\_\_\_\_ feet to \_\_\_\_\_ feet for each plug set.

Checked hole, pushed plug to 3750' and ran 5 sacks cement.  
Shot pipe at 3510', 3023', 2965', 2748', 2641', 2550', 2450',  
2340', pulled 75 joints of 5 1/2" casing. Allied pumped 25 sacks  
mud, 1 sack hulls and 120 sacks cement.

RECEIVED  
STATE CORPORATION COMMISSION

PLUGGING COMPLETE.

12-1-75 DEC 1 1975

(If additional description is necessary, use BACK of this sheet)  
Name of Plugging Contractor KNIGHT CASING PULLING CO., INC. CONSERVATION DIVISION  
Address CHASE, KANSAS Wichita, Kansas

STATE OF KANSAS COUNTY OF RICE ss.  
NOEL J. KNIGHT

(employee of owner) or (owner or operator) of the above-described well, being first duly sworn on oath, says: That I have knowledge of the facts, statements, and matters herein contained and the log of the above-described well as filed and that the same are true and correct. So help me God.

(Signature) Noel Knight  
CHASE, KANSAS  
(Address)

SUBSCRIBED AND SWORN TO before me this 25th day of November, 19 75

My commission expires \_\_\_\_\_  
NOTARY PUBLIC MARGARET MELCHER  
Rice County, Ks.  
My Comm. Exp. Feb. 15, 1979

Notary Public.

EMPHASIS OIL OPERATIONS

P. O. Box 506  
Russell, Kansas 67665

DRILLERS LOG

OPERATOR: Emphasis Oil Operations  
P. O. Box 506  
Russell, Kansas 67665

CONTRACTOR: Company Tools

LEASE: Russell

WELL: #1

LOCATION: SW-SE-NE  
Sec. 7-20S-16W  
Pawnee County, Kansas

Total Depth: 3812'

Elevation: 2074' R.B.

Commenced: 4-22-75

Completed 5-3-75

Casing: 8-5/8" @ 249'  
5-1/2" @ 3809'

Status: Oil Well

DEPTHS & FORMATIONS

(All Measurements from R.B.)

Soil & shale	260	Shale	1543
Shale & shells	518	Shale & lime	2173
Sand	670	Lime & shale	3100
Shale	1155	Lime	3810
Anhydrite	1175	Arbuckle	3812

STATE OF KANSAS ]  
COUNTY OF RUSSELL ]

I, Joe K. Branum, of Emphasis Oil Operations, state the above and foregoing is a true and correct log of the above captioned well.

*Joe K. Branum*

Joe K. Branum

Subscribed and sworn to before me this 3<sup>rd</sup> day of May, 1975.

My commission expires: November 13, 1975.

*Mary A. Branum*

Notary Public

RECEIVED  
STATE DEPARTMENT COMMISSION

NOV 6 1975

CONSERVATION DIVISION  
Wichita, Kansas