


STATE OF KANSAS
STATE CORPORATION COMMISSION

Give All Information Completely
Make Required Affidavit
Mail or Deliver Report to:
Conservation Division
State Corporation Commission
211 No. Broadway
Wichita, Kansas

WELL PLUGGING RECORD

NORTH

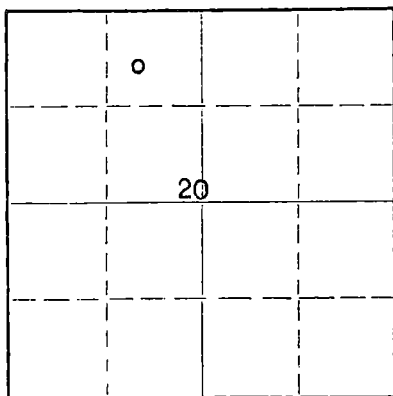

Locate well correctly on above
Section Plat

Ness

County. Sec. 20 Twp. 19S Rge. 25 (W)

Location as "NE/CNW/SW" or footage from lines C NE NW

Lease Owner Sunray DX Oil Company

Lease Name Lloyd Spruill

Well No. 1

Office Address P. O. Box 729, Great Bend, Kansas

Character of Well (completed as Oil, Gas or Dry Hole) Dry Hole

Date well completed 2-11 1964

Application for plugging filed 2-11 1964

Application for plugging approved 2-11 1964

Plugging commenced 2-11 1964

Plugging completed 2-11 1964

Reason for abandonment of well or producing formation

No commercial oil found

If a producing well is abandoned, date of last production 19

Was permission obtained from the Conservation Division or its agents before plugging was commenced? Yes

Name of Conservation Agent who supervised plugging of this well Mr. Eldon Petty, Hays, Kansas

Producing formation --- Depth to top --- Bottom --- Total Depth of Well 4668 Feet

Show depth and thickness of all water, oil and gas formations.

OIL, GAS OR WATER RECORDS

CASING RECORD

FORMATION	CONTENT	FROM	TO	SIZE	PUT IN	PULLED OUT
Mississippi		4510'		8-5/8"	643'	None
Cherokee		4408'				

Describe in detail the manner in which the well was plugged, indicating where the mud fluid was placed and the method or methods used in introducing it into the hole. If cement or other plugs were used, state the character of same and depth placed, from --- feet to --- feet for each plug set.

Ran drill pipe and spotted cement plugs at:

35 sacks Reg. Pozmix from 495' to 600'

15 sacks Reg. Pozmix from 35' to 80'

All intervals between cement plugs are filled with
10.0# mud laden fluid. A cap was welded on top of
8-5/8" surface pipe.

RECEIVED
STATE CORPORATION COMMISSION

FEB 20 1964

Copy of Driller's Log attached

CONSERVATION DIVISION
Wichita, Kansas

(If additional description is necessary, use BACK of this sheet)

Name of Plugging Contractor Stickle Drilling Company

Address Wichita, Kansas

STATE OF KANSAS, COUNTY OF BARTON, ss.
C. C. SHREVE

(employee of owner) or (owner or operator) of the above-described well, being first duly sworn on oath, says: That I have knowledge of the facts, statements, and matters herein contained and the log of the above-described well as filed and that the same are true and correct. So help me God.

(Signature) C. C. Shreve, District Manager

P. O. Box 729, Great Bend, Kansas

(Address)

SUBSCRIBED AND SWORN to before me this 19th day of February, 1964

My commission expires February 22, 1967

D. L. Jackson

Notary Public.



Sunray DX Oil Company
Tulsa, Oklahoma

15.135.00 547.00 00
Tulsa, Oklahoma
February 17, 1964

634-40
R

Contractor: Stickle Drilling Company
Date Commenced: February 1, 1964
Date Completed: February 10, 1964

Lloyd Spruill No. 1
NE NW Section 20-19S-25W
Ness County, Kansas

DRILLER'S LOG

Depth Figures Indicate Base of Formations:

Clay and shale	50
Surface clay and shale	645
Shale and shells	1980
Shale	2428
Shale and lime	2940
Lime and shale	3098
Shale and lime	3610
Lime and shale	4050
Lime	4668 TD

I, Fred E. Stickle, hereby certify the above to be a true and complete Driller's Log of Sunray DX Oil Company's Lloyd Spruill No. 1, NE NW, Section 20-19S-25W, Ness County, Kansas.

Fred E. Stickle
FRED E. STICKLE

M. Hensley
Notary Public

My Commission Expires January 11, 1967

RECEIVED
STATE CORPORATION COMMISSION

FEB 20 1964

CONSERVATION DIVISION
Wichita, Kansas