

STATE OF KANSAS
STATE CORPORATION COMMISSION


WELL PLUGGING RECORD

Give All Information Completely
Make Required Affidavit
Mail or Deliver Report to:
Conservation Division
State Corporation Commission
211 No. Broadway
Wichita, Kansas

NESS County, Sec. 4 Twp. 19S Rge. 25 (E) W (W)

Location as "NE/CNW/SW" or footage from lines SW, SE, SE
Lease Owner DRYOR & TRACY
Lease Name SPRULL Well No. 1
Office Address 714 UNION CENTER BLDG., WICHITA, KANSAS
Character of Well (completed as Oil, Gas or Dry Hole) DRY ROTARY
Date well completed MARCH 11 19 60
Application for plugging filed MARCH 11 19 60
Application for plugging approved MARCH 11 19 60
Plugging commenced MARCH 11 19 60
Plugging completed MARCH 11 19 60
Reason for abandonment of well or producing formation No productive zone.

NORTH

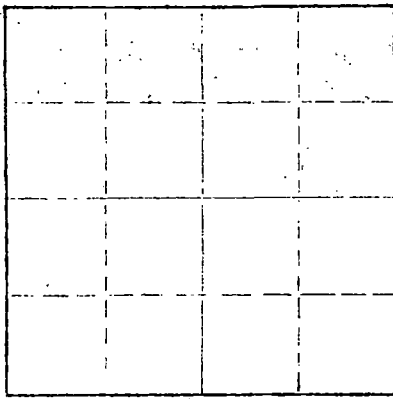

Locate well correctly on above
Section Plat

If a producing well is abandoned, date of last production 19
Was permission obtained from the Conservation Division or its agents before plugging was commenced? Yes

Name of Conservation Agent who supervised plugging of this well Gilbert P. Leiker
Producing formation _____ Depth to top _____ Bottom _____ Total Depth of Well 4500 Feet
Show depth and thickness of all water, oil and gas formations.

OIL, GAS OR WATER RECORDS

CASING RECORD

FORMATION	CONTENT	FROM	TO	SIZE	PUT IN	PULLED OUT
				8 5/8"	280'	

Describe in detail the manner in which the well was plugged, indicating where the mud fluid was placed and the method or methods used in introducing it into the hole. If cement or other plugs were used, state the character of same and depth placed, from _____ feet to _____ feet for each plug set.

Canned up pits forming heavy mud, filled hole up to 270' with heavy mud, pushed wooden plug and 4 ex. hulls to 270', capped with 20 ex. cement through drill pipe.
Filled hole up to 35' with heavy mud, pushed wooden plug and 4 ex. hulls to 35' and filled hole up to base of well collar with 10 ex. cement.

(If additional description is necessary, use BACK of this sheet)

Name of Plugging Contractor GALVIN DRILLING COMPANY
Address ROUTE #2, GREAT BEND, KANSAS

STATE OF KANSAS COUNTY OF BARTON ss.
VERNE A. MORRIS (employee of owner) or (owner) of the above-described

well, being first duly sworn on oath, says: That I have knowledge of the facts, statements, and matters herein contained and the log of the above-described well as filed and that the same are true and correct. So help me God.

(Signature) Verne A. Morris
ROUTE #2, GREAT BEND, KANSAS
(Address)

SUBSCRIBED AND SWORN TO before me this 24th day of March, 19 60

My commission expires November 12, 1962

[Signature] Notary Public

WELL LOG

15.135.00155.00.00

COMPANY PRYOR & TRACY

SEC. 4 T.19S R. 25W

FARM SPRUILL

NO. 1

LOC. SW, SE, SE


TOTAL DEPTH 4580'

COUNTY NESS CO., KANSAS

COMM. February 28, 1960

COMP. March 11, 1960

CONTRACTOR GARVEY DRILLING COMPANY

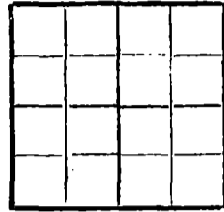

CASING 8 5/8" @ 280' w/175 spx.

ELEVATION 2508' DF

PRODUCTION D & A

FIGURES INDICATE BOTTOM OF FORMATIONS

280	Post rock & blue shale
1164	Shale
1196	Anhydrite
1267	Shale
1496	Sand
1530	Shale
1910	Shale & shells
2320	Shale
2769	Shale & lime
2840	Lime
3135	Lime & shale
3630	Lime
3745	Lime & shale
3780	Lime
3860	Shale & lime
3910	Lime & shale
4264	Lime
4520	Lime & shale
4530	Conglomerate
4580	Mississippi
4580	T. D.

State of KANSAS
County of BARTON } ss:

I, VERNE A. MORRIS of GARVEY DRILLING COMPANY

upon oath state that the above and foregoing is a true and correct copy of the log of the #1 SPRUILL well.

Verne A. Morris

Subscribed and sworn to before me this 17th day of March 19 60

My Commission Expires November 12, 1962

[Signature]
NOTARY PUBLIC