


WELL PLUGGING RECORD

Give All Information Completely
Make Required Affidavit
Mail or Deliver Report to:
Conservation Division
State Corporation Commission
212 No. Market
Wichita, Kansas

NORTH

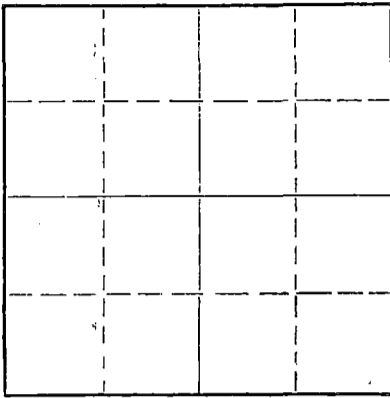

Locate well correctly on above
Section Plat

Ness County, Sec. 6 Twp. 19S Rge. 24W ~~XXX~~ (W)

Location as "NE/CNW/SW" or footage from lines C NE NE
Lease Owner McClure Oil Co.
Lease Name Antenen Old Well Workover Well No. _____
Office Address 1301 Wichita Plaza Bldg., Wichita, Kansas 67202
Character of Well (completed as Oil, Gas or Dry Hole) Dry Hole
Date well completed 10-25-67 19
Application for plugging filed 10-25-67 19
Application for plugging approved 10-25-67 19
Plugging commenced 10-25-67 19
Plugging completed 10-25-67 19
Reason for abandonment of well or producing formation Dry Hole

If a producing well is abandoned, date of last production _____ 19
Was permission obtained from the Conservation Division or its agents before plugging was commenced? yes

Name of Conservation Agent who supervised plugging of this well Leo Massey
Producing formation _____ Depth to top _____ Bottom _____ Total Depth of Well 4440 Feet
Show depth and thickness of all water, oil and gas formations.

OIL, GAS OR WATER RECORDS

CASING RECORD

FORMATION	CONTENT	FROM	TO	SIZE	PUT IN	PULLED OUT
				Previously set		

Describe in detail the manner in which the well was plugged, indicating where the mud fluid was placed and the method or methods used in introducing it into the hole. If cement or other plugs were used, state the character of same and depth placed, from _____ feet to _____ feet for each plug set.

70 sks. 50/50 Posmix @ 720' through drill pipe
20 sks. 50/50 Posmix @ 390' through drill pipe
Bridged @ 40' with 10 sacks cement

NOV 21 1967

(If additional description is necessary, use BACK of this sheet)

Name of Plugging Contractor Leben Drilling, Inc.
Address Box 486, Great Bend, Kansas 67530

STATE OF KANSAS, COUNTY OF BARTON, ss.
Leslie Kite (employee of owner) or (owner or operator) of the above-described well, being first duly sworn on oath, says: That I have knowledge of the facts, statements, and matters herein contained and the log of the above-described well as filed and that the same are true and correct. So help me God.

(Signature) Leslie Kite
Box 486, Great Bend, Kansas 67530 (Address)

SUBSCRIBED AND SWORN TO before me this 15th day of November, 1967

My commission expires April 1, 1971 Ulanda Nichols Notary Public.

DRILLER'S LOG

COMPANY: McClure Oil Company
 CONTRACTOR: LEBEN DRILLING, INC.
 FARM: ANTENEN #1 Washdown Well
 LOCATION: C NE NE SECTION 6-19S-24W
 NESS COUNTY, KANSAS
 COMMENCED: 10-23-67
 COMPLETED: 10-25-67

0 4442 Washed Down
 4442 RTD - D. & A.

Surface Casing set by Previous Operator

I, Leslie Kite, do hereby certify that the above and foregoing is a true and correct copy of the log of the Antenen #1 Washdown Well, located C NE NE of Section 6, Township 19 South, Range 24 West, Ness County, Kansas, as reflected by the records of Leben Drilling, Inc.

Leslie Kite
 Leslie Kite

STATE OF KANSAS)
) SS
 COUNTY OF BARTON)

Subscribed and sworn to and before me, a Notary Public, in and for Barton County, Kansas, this 27th day of October, 1967.

Ulanda Nichols
 Ulanda Nichols


My Commission Expires:
April 1, 1971

RECEIVED
STATE CORPORATION COMMISSION

OCT 30 1967

CONSERVATION DIVISION
Wichita, Kansas

15.135.30360.00 01

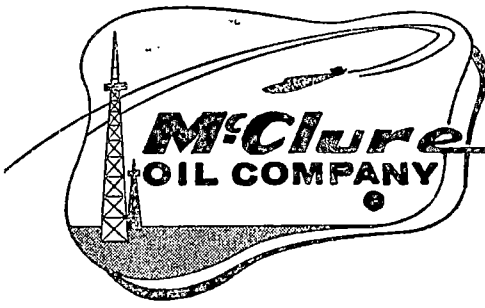

Alma, Michigan

RECEIVED
STATE CORPORATION COMMISSION

Reply to:

KANSAS DISTRICT OFFICE
1301 PLAZA BUILDING
WICHITA, KANSAS 67202
PHONE AM 4-4363

November 20, 1967

NOV 21 1967

STATE CORPORATION COMMISSION
WICHITA, KANSAS

The State Corporation Commission
Conservation Division
212 N. Market
Wichita, Kansas 67202

Re: #1 Antenen OWWO
C NE NE Section 6-19S-24W
Ness County, Kansas

Dear Sirs:

We are enclosing herewith the original Well Plugging Record in connection with the captioned well. We assume you have already been furnished with the well plugging application by Leben Drilling, Inc.

Yours very truly,

McCLURE OIL COMPANY

Everest E. Wible
Everest E. Wible

dh
attach.