
15.135.00175.00.00

STATE OF KANSAS
STATE CORPORATION COMMISSION

Give All Information Completely
Make Required Affidavit
Mail or Deliver Report to:
Conservation Division
State Corporation Commission
211 No. Broadway
Wichita, Kansas

WELL PLUGGING RECORD

NORTH

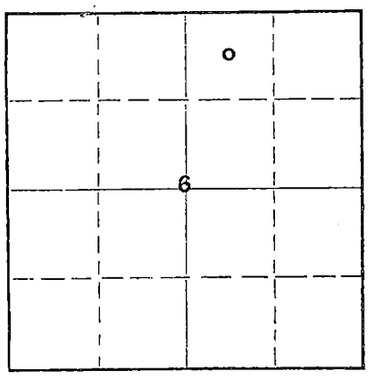

Locate well correctly on above Section Plat

Ness County. Sec. 6 Twp. 19S Rge. 23W (E) (W)

Location as "NE/CNW¼SW¼" or footage from lines C NW NE

Lease Owner Hellar Drilling Company, Inc.

Lease Name Adolph Langer Well No. 1

Office Address 1014 Union Center, Wichita, Kansas

Character of Well (completed as Oil, Gas or Dry Hole) Dry Hole

Date well completed 3-30 19 62

Application for plugging filed 3-30 19 62

Application for plugging approved 3-30 19 62

Plugging commenced 3-30 19 62

Plugging completed 3-30 19 62

Reason for abandonment of well or producing formation Dry Hole

If a producing well is abandoned, date of last production 19

Was permission obtained from the Conservation Division or its agents before plugging was commenced? Yes

Name of Conservation Agent who supervised plugging of this well Eldon Petty

Producing formation Depth to top Bottom Total Depth of Well 4327 Feet

Show depth and thickness of all water, oil and gas formations.

OIL, GAS OR WATER RECORDS — CASING RECORD

FORMATION	CONTENT	FROM	TO	SIZE	PUT IN	PULLED OUT
		0	225'	8-5/8"	228.56'	None

Describe in detail the manner in which the well was plugged, indicating where the mud fluid was placed and the method or methods used in introducing it into the hole. If cement or other plugs were used, state the character of same and depth placed, from feet to feet for each plug set.

Filled hole with mud to 220', set first plug using 1/4 sack hulls and 20 sacks cement. Filled with mud to 40', set second plug using 1/4 sack hulls and 10 sacks cement.

RECEIVED
STATE CORPORATION COMMISSION
APR 11 1962
CONSERVATION DIVISION
Wichita, Kansas

(If additional description is necessary, use BACK of this sheet)

Name of Plugging Contractor Hellar Drilling Company, Inc.

Address 1014 Union Center, Wichita, Kansas

STATE OF KANSAS, COUNTY OF SEDGWICK, ss.

D.L. Hellar, President Hellar Drilling Co. (owner or ~~owner~~) of the above-described well, being first duly sworn on oath, says: That I have knowledge of the facts, statements, and matters herein contained and the log of the above-described well as filed and that the same are true and correct. So help me God.

(Signature) D L Hellar

1014 Union Center
(Address)

SUBSCRIBED AND SWORN TO before me this 10th day of April, 19 62

Notary Public.

My commission expires March 6, 1965.

15.135.00175.00.00

DRILLER'S LOG

COMPANY: Hellar Drilling Company, Inc.
LEASE: #1 Adolph Langer
LOCATION: C NW NE, Section 6-19S-23W
Ness County, Kansas
COMMENCED: March 20, 1962
COMPLETED: March 30, 1962
CASING: Set 8-5/8" surface casing
@ 225/ 175 sacks cement.

0 - 129	Surface sand, sand rock
129 - 195	Clay, shale
195 - 225	Blue shale
225 - 1410	Shale, sand, red bed
1410 - 1475	Red bed
1475 - 1519	Anhydrite
1519 - 1870	Red bed, shale
1870 - 2220	Shale, lime
2220 - 2375	Lime, shale
2375 - 2468	Salt section
2468 - 2568	Shale, lime
2568 - 2634	Lime, shale
2634 - 2900	Shale, lime
2900 - 2975	Lime, shale
2975 - 3397	Shale, lime
3397 - 3665	Lime, shale
3665 - 3905	Lansing-Kansas City
3905 - 3973	Lime
3973 - 4103	Lime, shale
4103 - 4218	Lime
4218 - 4269	Lime, shale
4269 - 4327	Mississippian
4327	Rotary Total Depth
	D & A

RECEIVED
STATE CORPORATION COMMISSION
APR 11 1962
CONSERVATION DIVISION
Wichita, Kansas

STATE OF KANSAS)
) SS:
COUNTY OF SEDGWICK)

I, D. L. Hellar, do hereby certify that the above and foregoing is a true and correct copy of the log of the #1 ADOLPH LANGER, located in the C NW NE Section 6-19S-23W, Ness County, Kansas, as reflected by the files of the Hellar Drilling Company, Inc.

HELLAR DRILLING COMPANY, INC.

BY D. L. Hellar
D.L. Hellar, President

Subscribed and sworn to before me, a Notary Public, in and for Sedgwick County, Kansas, this 10th day of April, 1962.

Wanda Lou Bruce
Notary Public

My commission expires March 6, 1965.