


Give All Information Completely
Make Required Affidavit
Mail or Deliver Report to:
Conservation Division
State Corporation Commission
211 No. Broadway
Wichita, Kansas

WELL PLUGGING RECORD

NORTH

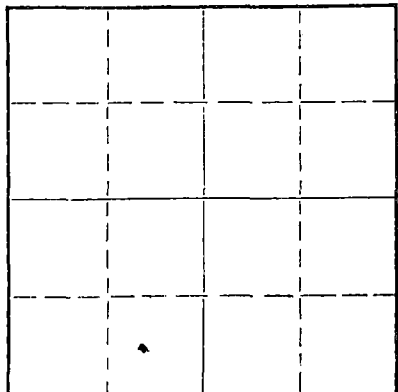

Locate well correctly on above
Section Plat

Ness County, Sec. 29 Twp. 19S Rge. 21 (E) W. (W)
Location as "NE/CNW/SW" or footage from lines 150' W. of Gen. SE SW
Lease Owner: Cities Service Oil Company
Lease Name: Rein "A" Well No. 3
Office Address: Box 308, Great Bend, Kansas
Character of Well (completed as Oil, Gas or Dry Hole) Dry Hole
Date well completed May 16, 19 65
Application for plugging filed May 16, 19 65
Application for plugging approved May 16, 19 65
Plugging commenced May 16, 19 65
Plugging completed May 17, 19 65
Reason for abandonment of well or producing formation Dry

If a producing well is abandoned, date of last production 19
Was permission obtained from the Conservation Division or its agents before plugging was commenced? Yes

Name of Conservation Agent who supervised plugging of this well Eldon Petty
Producing formation Depth to top Bottom Total Depth of Well 4462 Feet
Show depth and thickness of all water, oil and gas formations.

OIL, GAS OR WATER RECORDS

CASING RECORD

FORMATION	CONTENT	FROM	TO	SIZE	PUT IN	PULLED OUT
				8-5/8"	516'	None

Describe in detail the manner in which the well was plugged, indicating where the mud fluid was placed and the method or methods used in introducing it into the hole. If cement or other plugs were used, state the character of same and depth placed, from feet to feet for each plug set.

4462-510', mud.
510-445', 20 sacks cement.
445-240', mud.
240-175', 20 sacks cement.
175-40', mud.
40' to base of cellar, 10 sacks cement.

RECEIVED
STATE CORPORATION COMMISSION
MAY 26 1965
CONSERVATION DIVISION
Wichita, Kansas

(If additional description is necessary, use BACK of this sheet)

Name of Plugging Contractor Peel Brothers, Inc.
Address Hoisington, Kansas

STATE OF Kansas, COUNTY OF Barton, ss.
W. J. Devaney (employee of owner) or (owner/contractor) of the above-described

well, being first duly sworn on oath, says: That I have knowledge of the facts, statements, and matters herein contained and the log of the above-described well as filed and that the same are true and correct. So help me God.

(Signature) *W. J. Devaney*
Box 308, Great Bend, Kansas (Address)

SUBSCRIBED AND SWORN TO before me this 24th day of May, 19 65

My commission expires Dec. 6, 1966. *W. J. Devaney* Notary Public.

15.135.30051.00.00

0661-04-10M

WELL RECORD

WILDCAT _____

DISCOVERY _____

POOL _____

Company Cities Service Oil Co. Well No. #3 Farm Rein "A"

Location 660' from S.L. & 1830' from W.L. Sec. 29 T. 19S R. 21W

Elev. Serv. K.B. 2295' D.F. 2292' Gr. 2287' Co. Ness State Kansas

N. I. P. Dry Hole A. I. P. _____ Grav. _____

Pay Zones _____

Perforations None

Acid None Hydrafrac _____

T. D. 4462' P. B. T. D. _____ N. T. D. _____ Drlg. Comm. 5/6/65 Drlg. Comp. 5/16/65

CASING RECORD:

8 5/8" @ 516' w/275 sacks.

Formation Record:

Formation Record:	Depth:
shale & shells	0 - 280
shale	945
sand	1165
shale & red bed	1517
anhydrite	1548
shale	1600
shale & shells	1880
shale & lime	2410
lime	2890
lime & shale	3000
shale & lime	3560
lime & shale	3655
lime	4445
lime, shale & chert	4462 R.T.D.

Contractor Peel Brothers, Inc.

Log Tops:

Heebner	3784 (-1489)
Toronto	3802 (-1507)
Lansing	3833 (-1538)
Fort Scott	4346 (-2051)
Cherokee	4366 (-2071)
Conglomerate	4419 (-2124)
Warsaw	4442 (-2147)
Osage	4448 (-2153)
Log T.D.	4458 (Did not reach bottom.)

Eastman:

10	- 1000'
10	- 1500'
10	- 2455'
10	- 4010'

Plugged & Abandoned 5/17/65

VJQ/ng
8/5/65

RECEIVED
STATE CORPORATION COMMISSION

AUG 17 1965

CONSERVATION DIVISION
Wichita, Kansas