


Give All Information Completely
Make Required Affidavit
Mail or Deliver Report to:
Conservation Division
State Corporation Commission
211 No. Broadway
Wichita, Kansas

WELL PLUGGING RECORD

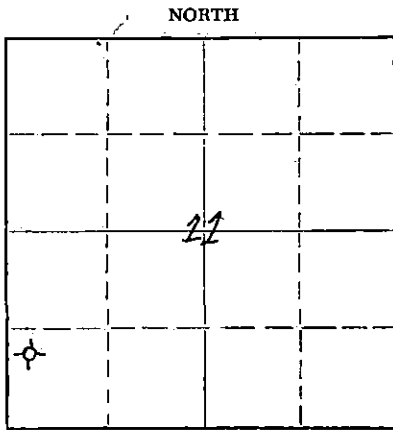

Locate well correctly on above
Section Plat

Ellsworth County, Sec. 11 Twp. 17 Rge. 10 ~~XX~~ (W)

Location as "NE/CNW/SW" or footage from lines NW SW SW

Lease Owner D. R. Lauck Oil Company, Inc.

Lease Name E. Revert Well No. 11

Office Address 301 South Broadway Wichita Kans

Character of Well (completed as Oil, Gas or Dry Hole) dry hole

Date well completed June 16 19 56

Application for plugging filed June 16 19 56

Application for plugging approved June 16 19 56

Plugging commenced June 16 19 56

Plugging completed June 16 19 56

Reason for abandonment of well or producing formation dry hole

If a producing well is abandoned, date of last production 19

Was permission obtained from the Conservation Division or its agents before plugging was commenced? yes

Name of Conservation Agent who supervised plugging of this well Mr. Ruel Durkee

Producing formation Depth to top Bottom Total Depth of Well 3300 Feet

Show depth and thickness of all water, oil and gas formations.

OIL, GAS OR WATER RECORDS

CASING RECORD

FORMATION	CONTENT	FROM	TO	SIZE	PUT IN	PULLED OUT
		0	231'	8 5/8"	231	none

Describe in detail the manner in which the well was plugged, indicating where the mud fluid was placed and the method or methods used in introducing it into the hole. If cement or other plugs were used, state the character of same and depth placed, from feet to feet for each plug set.

mud 3300 to 225'
plug 225 to 221
cement 221 to 30
plug 30 to 26
cement 26 to 6 bottom of cellar

6-29-56

(If additional description is necessary, use BACK of this sheet)

Name of Plugging Contractor Sun Cementing Co.

Address Great Bend Kansas

STATE OF Kansas, COUNTY OF Sedgwick, ss.

John H. Knightley (employee of owner) or (owner or operator) of the above-described well, being first duly sworn on oath, says: That I have knowledge of the facts, statements, and matters herein contained and the log of the above-described well as filed and that the same are true and correct. So help me God.


(Signature)

Wichita Kansas
(Address)

SUBSCRIBED AND SWORN to before me this 19 day of June, 19 56

My commission expires Sept. 14, 1959

Notary Public.

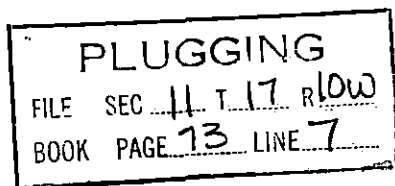

D. R. Lauck Oil Company, Inc.

✓ Frevert No. 11

NW SW Sec. 11-17S-10W
Ellsworth County Kans.

Commenced: June 8, 1956

Completed: June 16, 1956

Casing record: 231' 8 5/8" cemented with 150 sacks.

Elevation: GR 1785; DF 1788; KB 1791;

Drillers LogTops

sand & clay	130
sand & shale	180
shale & shells	390
red bed & shale	520
Anhydrite & shale	550
sand & shale	600
shale & red bed	1185
shale & shells	1250
Anhydrite	1350
shale & shells	1445
Lime & shale	1955
shale & lime shells	2170
shale	2344
shale & shells	2500
lime & shale	2640
lime	2834
shale	2860
lime & shale	2916
lime	3300

Rotary Total Depth 3300

Heebner	2802-1011
Brown Lime	2907-1116
Lansing	2933-1142
Conglomerate	3237-1446
Arbuckle	3271-1480
Rotary Total Depth	3300-1509

D & A

PLUGGING

 RECEIVED
 DEPARTMENT OF COMMISSION

 SECURED
 1956