

STATE OF KANSAS
STATE CORPORATION COMMISSION

WELL PLUGGING RECORD

OR
FORMATION PLUGGING RECORD Strike out upper line when reporting plugging off formations.

Give All Information Completely
Make Required Affidavit
Mail or Deliver Report to:
Conservation Division
State Corporation Commission
800 Bitting Building
Wichita, Kansas

Ellsworth County. Sec. 11 Twp. 17 Rge. 10 (E) (W)

Location as "NE $\frac{1}{4}$ NW $\frac{1}{4}$ SW $\frac{1}{4}$ " or footage from lines

Lease Owner Ferd H. Sabourin

Lease Name Peterman Well No. 1

Office Address Box 293, Great Bend, Kansas

Character of Well (completed as Oil, Gas or Dry Hole) Oil

Date well completed 1-13-1944

Application for plugging filed May 5 1951

Application for plugging approved May 9 1951

Plugging commenced June 8 1951

Plugging completed June 17 1951


Reason for abandonment of well or producing formation

Depleted oilwell

If a producing well is abandoned, date of last production July 1950

Was permission obtained from the Conservation Division or its agents before plugging was commenced? yes File No. 80-28

NORTH 10N

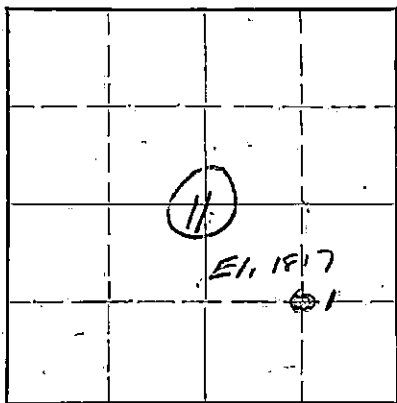

Locate well correctly on above Section Plat

Name of Conservation Agent who supervised plugging of this well Ruel Durkee

Producing formation Arbuckle Depth to top 3287 Bottom x Total Depth of Well 3297 Feet

Show depth and thickness of all water, oil and gas formations.

OIL, GAS OR WATER RECORDS

CASING RECORD

Formation	Content	From	To	Size	Put In	Pulled Out
Top Arbuckle				8 5/8"	227	none
				5 1/2"	3286	2213
This well has changed hands several times before being acquired from Russell Maguire by Ferd H. Sabourin and no log is available						

Describe in detail the manner in which the well was plugged, indicating where the mud fluid was placed and the method or methods used in introducing it into the hole. If cement or other plugs were used, state the character of same and depth placed, from _____ feet to _____ feet for each plug set.

- 3297 - 3280 sand
- 3280 - 3240 6 sax cement
- 3240 - 225 Mudded
- 225 - 215 Rock Bridge
- 215 - 170 Mud
- ~~170 - cellar~~
- 170 - 20 Mud
- 20 - cellar 5 sax cement

RECEIVED
STATE CORPORATION COMMISSION
JUN 30 1951
CONSERVATION DIVISION
Wichita, Kansas
6-30-51

(If additional description is necessary, use BACK of this sheet)
Correspondence regarding this well should be addressed to Ferd H. Sabourin
Address Box 293
Great Bend, Kansas

STATE OF Kansas, COUNTY OF Barton, ss.
Ferd H. Sabourin (employed by owner) or (owner proprietor) of the above-described well,

being first duly sworn on oath, says: That I have knowledge of the facts, statements, and matters herein contained and the log of the above-described well as filed and that the same are true and correct. So help me God.

(Signature) *Ferd H. Sabourin*
Ferd H. Sabourin
(Address)

SUBSCRIBED AND SWORN TO before me this 28th. day of June, 1951

My commission expires February 7 - 1954
Notary Public

PLUGGING
FILE SEC 11 T 17 R 10 W
BOOK PAGE 80 LINE 28