


Give All Information Completely
Make Required Affidavit
Mail or Deliver Report to:
Conservation Division
State Corporation Commission
211 No. Broadway
Wichita, Kansas

WELL PLUGGING RECORD

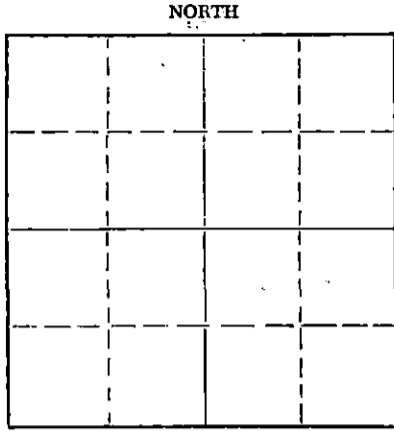

Locate well correctly on above
Section Plat

McPherson County. Sec. 2 Twp. 20 Rge. 4 (E) 4 (W)
Location as "NE/CNW/SW" or footage from lines NW NW SW
Lease Owner White & Ellis Drilling, Inc.-Pack Oil Co., Inc.
Lease Name Ferguson Well No. 1
Office Address Box 448 El Dorado, Kansas
Character of Well (completed as Oil, Gas or Dry Hole) dry hole
Date well completed October 2 1956
Application for plugging filed October 2 1956
Application for plugging approved October 2 1956
Plugging commenced October 2 1956
Plugging completed October 2 1956
Reason for abandonment of well or producing formation dry hole

If a producing well is abandoned, date of last production 19
Was permission obtained from the Conservation Division or its agents before plugging was commenced? yes

Name of Conservation Agent who supervised plugging of this well Ruel Durkee
Producing formation _____ Depth to top _____ Bottom _____ Total Depth of Well 3834 Feet
Show depth and thickness of all water, oil and gas formations.

OIL, GAS OR WATER RECORDS

CASING RECORD

FORMATION	CONTENT	FROM	TO	SIZE	PUT IN	PULLED OUT
				13"	240	none
				8 5/8	567	none

Describe in detail the manner in which the well was plugged, indicating where the mud fluid was placed and the method or methods used in introducing it into the hole. If cement or other plugs were used, state the character of same and depth placed, from _____ feet to _____ feet for each plug set.

Hole filled with heavy rotary mud to 255 ft. Bridge at 255 ft. with 5 ft. wood, rock and hulls. Pumped 15 sacks cement thru drill pipe on top of bridge.
Hole filled with heavy rotary mud to 20 ft. Bridge at 20 ft. with 5 ft. of wood, rock and hulls. Cap plug with 5 sacks cement.

(If additional description is necessary, use BACK of this sheet)

Name of Plugging Contractor White & Ellis Drilling, Inc.-License # 209
Address Box 448 El Dorado, Kansas

STATE OF Kansas, COUNTY OF Butler, ss.
Dale R. Daniel (employee of owner) of the above-described well, being first duly sworn on oath, says: That I have knowledge of the facts, statements, and matters herein contained and the log of the above-described well as filed and that the same are true and correct. So help me God.

(Signature) Dale R. Daniel
Box 448 El Dorado, Kansas
(Address)

SUBSCRIBED AND SWORN TO before me this 10 th day of October, 1956

My commission expires 4-6-59
Richard Loomis
Notary Public.

PLUGGING
FILE SEC. 2 T. 20 R. 4W
BOOK PAGE 205 LINE 23

RECEIVED
STATE CORPORATION COMMISSION
OCT 12 1956
10-12-56
CONSERVATION DIVISION

