


WELL PLUGGING RECORD

Give All Information Completely
Make Required Affidavit
Mail or Deliver Report to:
Conservation Division
State Corporation Commission
800 Bittling Building
Wichita, Kansas

Pawnee County, Sec 3 Twp 20S Rge 16 (W)

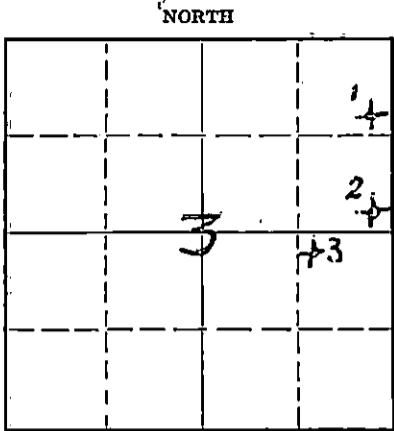

Locate well correctly on above Section Plat

Location as "NE/CNW $\frac{1}{4}$ SW $\frac{1}{4}$ " or footage from lines SE NE NE
Lease Owner Magnolia Petroleum Co.
Lease Name August Fleske Well No. 1
Office Address Box 900 - Dallas, Texas
Character of Well (completed as Oil, Gas or Dry Hole) Oil
Date well completed 6-7-45 19
Application for plugging filed 11-16-53 19
Application for plugging approved 11-17-53 19
Plugging commenced 11-30-53 19
Plugging completed 12-6-53 19
Reason for abandonment of well or producing formation Depleted

If a producing well is abandoned, date of last production 1-1-52 19
Was permission obtained from the Conservation Division or its agents before plugging was commenced? Yes

Name of Conservation Agent who supervised plugging of this well M. A. Rives
Producing formation Arbuckle Depth to top 3672 Bottom 3694 Total Depth of Well 3770 Feet
Show depth and thickness of all water, oil and gas formations.

OIL, GAS OR WATER RECORDS

CASING RECORD

Formation	Content	From	To	Size	Put In	Pulled Out
Arbuckle	Oil	3672	3694	8-5/8	1025	None
				5-1/2	3740	2053-1/2

Describe in detail the manner in which the well was plugged, indicating where the mud fluid was placed and the method or methods used in introducing it into the hole. If cement or other plugs were used, state the character of same and depth placed, from _____ feet to _____ feet for each plug set.

Measured in to plug back total depth 3734' - filled hole back to 3660' with crushed rock & dumped 5 sx cmnt. Shot csg off @ 2044' - pulled 18 jts of 5-1/2" csg out of hole. Pmpd 30 sx Halco Mud thru csg - finished pulling csg out of hole. Bailed hole down to 350' - set permanent rock bridge. Dumped 20 sx cmnt w/bailer. Filled hole to 35' of top w/heavy mud & dumped 10 sx cmnt for cap on well.

Work started 11-30-53, completed 12-6-53

All mudding & plugging done per M. A. Rives, State Pluggger

(If additional description is necessary, use BACK of this sheet)
Name of Plugging Contractor Forbes Casing Pulling Co.
Address P. O. Box 221, Great Bend, Ks.

STATE OF KANSAS, COUNTY OF BARTON, SS.
C. A. HILL, District Superintendent (Employee of State of Kansas) of the above-described well, being first duly sworn on oath, says: That I have knowledge of the facts, statements, and matters herein contained and the log of the above-described well as filed and that the same are true and correct. So help me God.

(Signature) *C. A. Hill*

Box 770 - Great Bend, Kansas
(Address)

SUBSCRIBED AND SWORN to before me this 10th day of December, 1953.

My commission expires Jan. 14, 1957

Harriett S. Kaiser
Notary Public.

PLUGGING
FILE DEC 3 T 20 R 16a
BOOK PAGE 43 LINE 12

12-11-53
CONC...

WELL LOG

August FLESKE #1
SE NE NE
Section 3-20S-16W
Pawnee County, Kansas

Mast commenced May 4, 1945
Mast completed May 4, 1945

Drilling Commenced May 5, 1945
Drilling Completed June 7, 1945

Contractor Barnett Drilling Company, Wichita, Kansas

8-5/8" Lapweld Csg 28# 8Rd Thd - new 1025' w/450 sx cmnt
5-1/2" Seamless Csg 14# 8Rd Thd J55 -New 3770' w/200 sx cmnt
2-1/2" Seamless Tubing 6 1/2# 8Rd Thd H40 new 3740'

Elevation 1991'

FORMATION:

Shale	0	185
Shale & shells	185	260
Sand	260	310
Shale	310	455
Sand	455	515
Shale	515	760
Shale & red rock	760	945
Shale	945	1015
Soft lime	1015	1019
Anhydrite	1019	1065
Red bed	1065	1100
Shale	1100	1610
Shale & shells	1610	1880
Lime	1880	2665
Shale & lime	2665	2740
Shale	2740	2840
Lime	2840	2895
Broken lime	2895	3005
Lime & shale	3005	3060
Lime	3060	3340
Lost circulation @ 3185		
Lime & shale	3340	3390
Top Kansas City	3390	
Lime	3390	3666
Cherty lime	3666	3668
Top Arbuckle	3668	
Arbuckle lime	3668	3700
Cherty lime	3700	3770
Ran Schlumberger Surveys before setting Csg.		
5-1/2" Csg set	3770	

PLUGGING

FILE SEC 3 T20 R 16W
BOOK PAGE 143 LINE 12

STATE OF KANSAS

DEPT. OF REVENUE

COMMISSIONER

WICHITA, KANSAS