

STATE OF KANSAS
STATE CORPORATION COMMISSION

Form CP-4

Give All Information Completely
Make Required Affidavit
Mail or Deliver Report to:
Conservation Division
State Corporation Commission
212 No. Market
Wichita, Kansas 67202

WELL PLUGGING RECORD

Barton County, Sec. 29 Twp. 20 Rge. 15 (E)W (W)

Location as "NE/CNW/SW" or footage from lines SW NE SW

Lease Owner Messman - Rinehart Oil Co.

Lease Name Schmidt Well No. # 1

Office Address 1432 Wichita Plaza ; Wichita, Ks. 67202

Character of Well (completed as Oil, Gas or Dry Hole) _____

Date well completed _____ 19 _____

Application for plugging filed _____ November 1971

Application for plugging approved _____ November 1971


Plugging commenced _____ December 30 1971

Plugging completed _____ January 7 1972

Reason for abandonment of well or producing formation _____

If a producing well is abandoned, date of last production _____ 19 _____

Was permission obtained from the Conservation Division or its agents before plugging was commenced? Yes

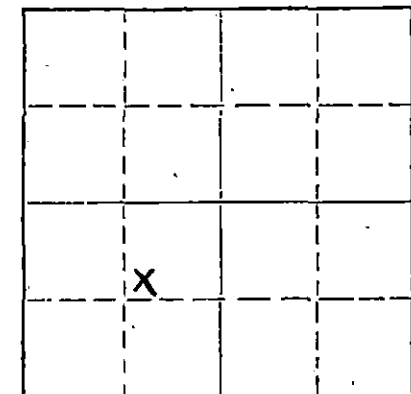

Locate well correctly on above Section Plat

Name of Conservation Agent who supervised plugging of this well Don Truan

Producing formation _____ Depth to top _____ Bottom _____ Total Depth of Well 3783 Feet

Show depth and thickness of all water, oil and gas formations.

OIL, GAS OR WATER RECORDS

CASING RECORD

FORMATION	CONTENT	FROM	TO	SIZE	PUT IN	PULLED OUT
				8 5/8"	736	None
				4 1/2"	3775	2004

Describe in detail the manner in which the well was plugged, indicating where the mud fluid was placed and the method or methods used in introducing it into the hole. If cement or other plugs were used, state the character of same and depth placed, from _____ feet to _____ feet for each plug set.

December 30, 1971 Plugged off bottom. Dumped sand to 3750'. Mixed and dumped 4 sx of cement.

January 7, 1972 Plugged off top. Globe Oil Well Cementing Co. mixed and pumped down 8 5/8" surface casing, 3 sx of bulls, 20 sx of gel, released plug and 100 sx of cement.

RECEIVED
STATE CORPORATION COMMISSION
JAN 20 1972
CONSERVATION DIVISION
Wichita, Kansas

(If additional description is necessary, use BACK of this sheet)

Name of Plugging Contractor RUSS CASING PULLING, INC.

Address P. O. BOX 1082 ; GREAT BEND, KANSAS 67530

STATE OF Kansas, COUNTY OF Sedgwick, ss.

J. A. Gilliland (employee of owner) or (owner or operator) of the above-described

well, being first duly sworn on oath, says: That I have knowledge of the facts, statements, and matters herein contained and the log of the above-described well as filed and that the same are true and correct. So help me God. MESSMAN-RINEHART OIL COMPANY

(Signature) J. A. Gilliland

J. A. Gilliland
1432 Wichita Plaza, Wichita, Kansas 67202
(Address)

Subscribed and sworn to before me this 12th day of January, 19 72

August 26, 1973

Arlene L. Sloop Notary Public.



NO. 1 PAUL SCHMIDTWell Record:

Location: SW/4 NE/4 SW/4
 Section 29-20S-15W
 Barton County, Kansas
Operator: Messman-Rinehart Oil Company
 518 Petroleum Building
 Wichita, Kansas
Contractor: Messman-Rinehart Oil Company
 518 Petroleum Building
 Wichita, Kansas
Casing Record: 8-5/8" @ 722' w/300 sx, cem., 6 sx, c.c.
 4-1/2" @ 3775' w/50 sx, cem., 1 sk, gel.

Commenced: June 7, 1962
Completed: June 19, 1962
 (Rotary)
Elevation: 2018' K/B
Production: Gas

* * * L O G * * *

Surface Clay	75
Shale & Shells	410
D. Sand	550
Shale	575
Red Bed	722
Shale	820
Red Bed & Shale	1020
Anhydrite	1045
Shale & Shells	1840
Lime & Shale	2150
Lime	2441
Lime & Shale	2552
Lime	2660
Shale & Lime	2785
Lime & Shale	3110
Lime	3765
Lime & Shale	3771
Arbuckle	3783 R.T.D.

RECEIVED
 STATE CORPORATION COMMISSION
 JAN 20 1972
 CONSERVATION DIVISION
 Wichita, Kansas

Sample Tops:

498
 1020' - Anhydrite (-1008)
 3354' - Heebner (-1336)
 3445' - Brown Lime (-1427)
 3457' - Lansing (-1439)
 3728' - Conglomerate (-1710)
 3771' - Arbuckle (-1753)

The undersigned, MESSMAN-RINEHART OIL COMPANY, hereby certifies that the above log is a true and correct log of the formation encountered in drilling the above well as reflected by the Daily Drilling Reports.

MESSMAN-RINEHART OIL COMPANY

By: J. A. Gilliland

J. A. Gilliland

Subscribed and sworn to before me
 this 26th day of June, 1962

Barbara J. Scott
 Barbara J. Scott, Notary Public

My Commission Expires: December 1, 1964

COMPLETION DATA

Messman-Rinehart Oil Company
No. 1 Paul Schmidt
SW/4 NE/4 SW/4, Sec. 29-20S-15W
Barton County, Kansas

- 6-25-62 - Moved in cable tools
- 6-26-62 - Treated with 250 gal. acid, swabbed back, kicked off and flowed at noon at the rate of 2,000 Mcfg, 845# csg. pressure
Shut well in
- 6-27-62 - Estimated open flow - 9,000 Mcfg/d
- 7-9-62 - Cities Service calculated open flow -- 11,150 Mcfg/d

MESSMAN-RINEHART OIL COMPANY

By: *Roger L. Messman*
Roger L. Messman

RLM/bjs
8/8/62

RECEIVED
STATE CORPORATION COMMISSION
JAN 20 1972
CONSERVATION DIVISION
Wichita, Kansas