


Give All Information Completely
Make Required Affidavit
Mail or Deliver Report to:
Conservation Division
State Corporation Commission
211 No. Broadway
Wichita, Kansas

WELL PLUGGING RECORD

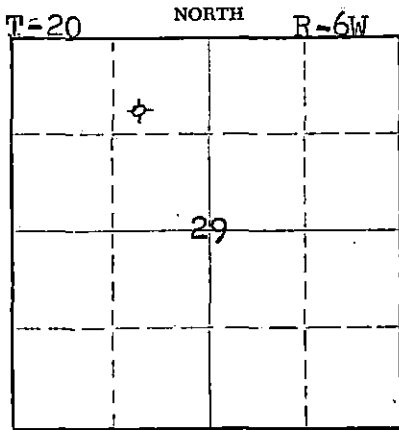

Locate well correctly on above Section Plat

Rice County. Sec. 29 Twp. 20 Rge. 6 (E) 6 (W)
Location as "NE/CNW%SW%" or footage from lines G SW NE NW
Lease Owner Donald T. Ingling et al
Lease Name J. Johannsen Well No. 1
Office Address 615 First Nat'l Bank Bldg., Wichita 2, Kans
Character of Well (completed as Oil, Gas or Dry Hole) Dry Hole
Date well completed November 13, 1960
Application for plugging filed November 13, 1960
Application for plugging approved November 13, 1960
Plugging commenced November 13, 1960
Plugging completed November 13, 1960
Reason for abandonment of well or producing formation dry

If a producing well is abandoned, date of last production 19
Was permission obtained from the Conservation Division or its agents before plugging was commenced? Yes

Name of Conservation Agent who supervised plugging of this well Gilbert Toman
Producing formation _____ Depth to top _____ Bottom _____ Total Depth of Well 3430 Feet
Show depth and thickness of all water, oil and gas formations.

OIL, GAS OR WATER RECORDS

CASING RECORD

FORMATION	CONTENT	FROM	TO	SIZE	PUT IN	PULLED OUT
				8 5/8"	200'	None

Describe in detail the manner in which the well was plugged, indicating where the mud fluid was placed and the method or methods used in introducing it into the hole. If cement or other plugs were used, state the character of same and depth placed, from _____ feet to _____ feet for each plug set.

Set bottom plug at 180 feet then 20 sacks cement.
Fill hole to within 40 feet of top then 10 sacks
cement - 2 sacks cement in rathole.

RECEIVED
STATE CORPORATION COMMISSION

NOV 18 1960

CONSERVATION DIVISION
Wichita, Kansas

(If additional description is necessary, use BACK of this sheet)

Name of Plugging Contractor Donald T. Ingling
Address Wichita 2, Kansas

STATE OF KANSAS, COUNTY OF SEDGWICK, ss.
D. T. Ingling (employee of owner) or (owner or operator) of the above-described well, being first duly sworn on oath, says: That I have knowledge of the facts, statements, and matters herein contained and the log of the above-described well as filed and that the same are true and correct. So help me God.

(Signature) [Signature]
615 First Nat'l Bank Bldg., Wichita 2,
(Address)

SUBSCRIBED AND SWORN TO before me this 16th day of November, 19 60

My commission expires Feb. 27, 1964

Notary Public.


WELL LOG BUREAU—KANSAS GEOLOGICAL SOCIETY
503 East Murdock, Wichita, Kansas

Company- DONALD T. INGLING ET AL
Farm- J. Johannsen No. 1

SEC. 29 T. 20 R. 6W
SW NE NW

Total Depth. 3430'
Comm. 11-4-60 Comp. 11-13-60
Shot or Treated.
Contractor.
Issued. 1-7-61

County Rice
KANSAS

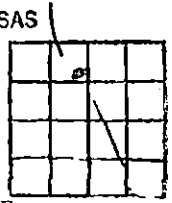

CASING:
8 5/8" 200' cem w/100 sx.

Elevation. 1649' RB

Production. Dry

Figures Indicate Bottom of Formations.

surface clay & red rock	70
shale, shells & red rock	200
shale & shells	1175
shale & sand streaks	1275
shale & lime	1305
lime	1685
lime & shale	2395
lime	2737
sand & shale	2846
lime - Brown	2860
shale	2868
lime - Lansing	2954
lime	3265
shale & lime	3315
lime & shale	3346
shaley- Conglomerate	3382
cherty - Mississippi	3413
chat - Mississippi	3430
Total Depth	

TOPS: SCOUT	
Douglas Sand	2703
Brown Lime	2846
Lansing	2868
Oolite Zone	3146
Shaley Conglomerate	3346
Cherty Conglomerate	3382
Mississippi Chat	3413