


STATE OF KANSAS  
STATE CORPORATION COMMISSION

Give All Information Completely  
Make Required Affidavit  
Mail or Deliver Report to:  
Conservation Division  
State Corporation Commission  
800 Bitting Building  
Wichita, Kansas

WELL PLUGGING RECORD

NORTH

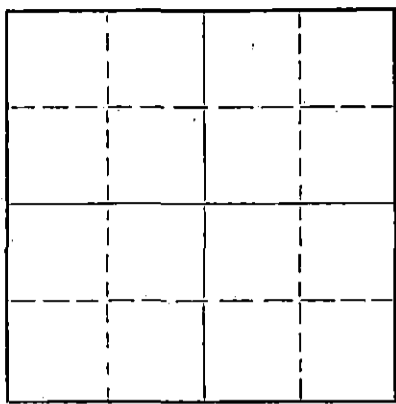

Locate well correctly on above  
Section Plat

Ellsworth County, Sec. 11 Twp. 17 Rge. (E) 10 (W)  
Location as "NE/CNW/SW" or footage from lines SE SE NW  
Lease Owner D. R. Lauck Oil Company Inc.  
Lease Name Frevert Well No. 10  
Office Address 301 South Broadway Wichita Kansas  
Character of Well (completed as Oil, Gas or Dry Hole) dry hole  
Date well completed February 25 19 52  
Application for plugging filed April 28 19 52  
Application for plugging approved April 28 19 52  
Plugging commenced May 1 19 52  
Plugging completed May 6 19 52  
Reason for abandonment of well or producing formation dry hole

If a producing well is abandoned, date of last production 19  
Was permission obtained from the Conservation Division or its agents before plugging was commenced? yes

Name of Conservation Agent who supervised plugging of this well C. D. Stough  
Producing formation \_\_\_\_\_ Depth to top \_\_\_\_\_ Bottom \_\_\_\_\_ Total Depth of Well 3285 1/2 Feet  
Show depth and thickness of all water, oil and gas formations.

OIL, GAS OR WATER RECORDS

CASING RECORD

FORMATION	CONTENT	FROM	TO	SIZE	PUT IN	PULLED OUT
Arbuckle	dry	surf	198	8 5/8"	198	none
				5 1/2"	3236	2829

Describe in detail the manner in which the well was plugged, indicating where the mud fluid was placed and the method or methods used in introducing it into the hole. If cement or other plugs were used, state the character of same and depth placed, from \_\_\_\_\_ feet to \_\_\_\_\_ feet for each plug set.

- 3285 - 3220 sand
- 3220 - 3190 cement 6 sax
- 3190 - 250 mud
- 250 - 240 rock bridge
- 240 - 165 cement
- 165 - 25 mud
- 25 - cellar - cement

(If additional description is necessary, use BACK of this sheet)

Name of Plugging Contractor R & S Pipe Pullers  
Address Ellinwood Kansas

STATE OF Kansas, COUNTY OF Sedgwick, ss.  
James F. Ralstin (employee of owner) or (owner or operator) of the above-described well, being first duly sworn on oath, says: That I have knowledge of the facts, statements, and matters herein contained and the log of the above-described well as filed and that the same are true and correct. So help me God.

(Signature) *James F. Ralstin*  
Wichita Kansas  
(Address)

SUBSCRIBED AND SWORN TO before me this 5th day of June, 19 52

My commission expires Sept. 14, 1955

*Elizabeth Gay*  
Notary Public.

PLUGGING  
FILE SEC. 11 T. 17 R. 10  
BOOK PAGE 12 LINE 20

RECEIVED  
STATE CORPORATION COMMISSION  
JUN 24 1952  
CONSERVATION DIVISION  
Wichita, Kansas

D. R. LAUCK OIL COMPANY INC. et.al.

Prevert #10 SE SE NW Sec.11-17-10W  
Ellsworth County

TD 3242

Commenced Feb. 7, 1952

Completed Feb. 25 1952

Elevation: 1780 DF

1782 Kelly Bushing

I. P. D&amp;A

8 5/8" casing 198' cemented


5 1/2" casing 3238' cemented with 57 sacks

surface clay	30
sand	35
shale & shells	315
sand & Iron	345
shale & shells	528
red bed shale & shells	
	1020
salt & shale	1210
shale & lime	2080
shale & shells	2300
Lime & shale	2380
shale & shells	2465
shale & lime	2535
Lime & shale	2565
Lime	2780
shale & lime	2915
Lime	3225
Conglomerate	3237
Lime	3242
Rotary T.D.	3242

Heebner	2782
Brown Lime	2889
White Lime	2914
Conglomerate	3223
Arbuckle	3235
Rotary T.D.	3240

## Standardized:

3246	Rainbow
3250	slight increase rainbow
3252	free oil
3265	Acidized 500 gallons 1075 lbs. did not recover load;
3266	Bailed 20 gal 1/3 oil
3273 1/2	trace water
3276	Bailed 60 gal. per hr 1/2-1/3 oil
3281	Increase water
3283 1/2	Big increase water
3285 1/2	Total Depth Dry & Abandoned

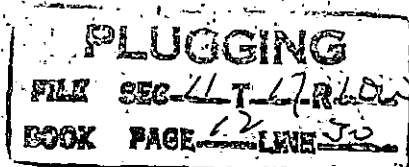RECEIVED  
STATE CORPORATION COMMISSION

JUN 24 1952

CONSERVATION DIVISION  
Wichita, Kansas