


WELL PLUGGING RECORD

Give All Information Completely
Make Required Affidavit
Mail or Deliver Report to:
Conservation Division
State Corporation Commission
800 Bitting Building
Wichita, Kansas

Ness County, Sec. 28 Twp. 16 Rge. 25 (E) (W)

Location as "NE/CNW/SW" or footage from lines NE NE NW
Lease Owner Rooney-Siegfried-Thomas
Lease Name H. W. McClean Well No. 1
Office Address P. O. Box 324, Great Bend, Kansas
Character of Well (completed as Oil, Gas or Dry Hole) Dry Hole
Date well completed December 7, 19 53
Application for plugging filed February 1, 19 54
Application for plugging approved February 1, 19 54
Plugging commenced February 3, 19 54
Plugging completed February 17, 19 54
Reason for abandonment of well or producing formation Non Commercial Production

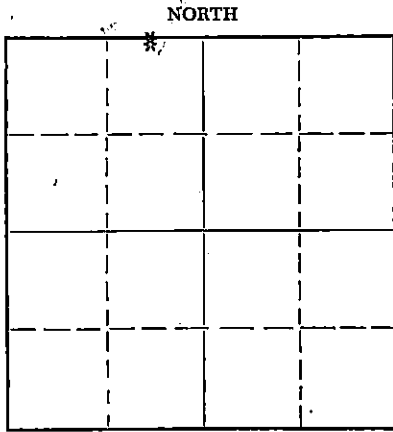

Locate well correctly on above Section Plat

If a producing well is abandoned, date of last production _____ 19 ____
Was permission obtained from the Conservation Division or its agents before plugging was commenced? Yes

Name of Conservation Agent who supervised plugging of this well Mr. Warren H. Horner
Producing formation Mississippi Depth to top 4504 Bottom _____ Total Depth of Well 4547 Feet
Show depth and thickness of all water, oil and gas formations.

OIL, GAS OR WATER RECORDS

CASING RECORD

FORMATION	CONTENT	FROM	TO	SIZE	PUT IN	PULLED OUT
Anhydrite (Stone Corral)	Marker	1952'	1985'	8- 5/8"	280'	None
Topeka	Dry	3612'		5 1/2"	4576.38'	2502.60'
Heebner	Marker	3880'	3883'			
Lansing	Dry	3919'				
BKC	Marker	4277'				
Ft. Scott	Dry	4430'				
Conglomorate	Marker	4499'	4504'			
Mississippi	Dry	4504'	4547'			

Describe in detail the manner in which the well was plugged, indicating where the mud fluid was placed and the method or methods used in introducing it into the hole. If cement or other plugs were used, state the character of same and depth placed, from _____ feet to _____ feet for each plug set.

TD 4547'
8-5/8 @ 280' Cement Circulated
5 1/2 - 1 1/2" J 55 @ 4547 W/150 Sx Cement Plug @ 4530'
Top Perforation 4523-30
P B D 4530 to 4487 Cement 10 Sx.
4487 to 275 Heavy Mud Circulated
275 to 265 Rock Bridge
265 to 220 Cement W/15 Sacks
220 to 40 Heavy Mud
40 to 35 Rock Bridge
35 to bottom of cellar 10 Sx. Cement

(If additional description is necessary, use BACK of this sheet)

Name of Plugging Contractor K - O Casing Pulling Company
Address 300 North Keystone, Stafford, Kansas Permit No. 206

STATE OF KANSAS, COUNTY OF BARTON, ss.
W. A. BORGESON (employee of owner) or (owner or operator) of the above-described well, being first duly sworn on oath, says: That I have knowledge of the facts, statements, and matters herein contained and the log of the above-described well as filed and that the same are true and correct. So help me God.

(Signature) W. A. Borgeson

(Address) _____

SUBSCRIBED AND SWORN to before me this 5th day of March

My commission expires May 3, 1957

24-7968-S 3-53-20M

PLUGGING
FILE SEC 28 T 16 R 25a
BOOK PAGE 11 LINE 33

STATE OF KANSAS
COMMISSIONER OF CONSERVATION
1954

Notary Public.

DRILLERS' LOG

H. W. McLEAN #1
Ness County, Kansas

Rooney-Seigfried & Thomas
Commenced October 22, 1953.
Completed November 5, 1953.

0-55	Surface Clay
55-75	Sand
75-280	Shale & Shells
280-450	Shale
450-1150	Shale & Sand
1150-1335	Shale & Shells
1335-1370	Anhydrite
1370-1910	Shale, Shells, Red Bed & Sand
1910-1970	Shale and Red Bed
1970-2000	Anhydrite, Shale & Red Bed
2000-2075	Shale, Shells & Red Bed
2075-2280	Shale & Shells
2280-2400	Shale & Lime Shells
2400-2450	Shale & Salt
2450-2680	Shale & Lime
2680-2745	Shale, Lime & Salt
2745-2948	Shale & Lime
2948-3015	Sandy Lime & Shale
3015-3615	Shale & Lime
3615-3730	Shale & Shells
3730-3910	Shale & Lime
3910-4270	Lime
4270-4547	Shale & Lime
4547	TOTAL DEPTH

I certify that the above is true and correct as being taken from the daily drilling reports of the H. W. McLean #1.


J. E. Selby
J. E. Selby, Bookkeeper
SCHAFFER DRILLING COMPANY

STATE OF KANSAS, COUNTY OF PRATT, SS:

Subscribed and sworn to before me this 9th day of November 1953.

Hilda Coulter
Notary Public

My commission expires February 25, 1956

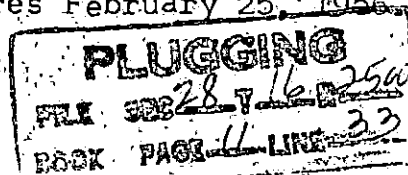

K-O CASING PULLING COMPANY
300 NORTH KEYSTONE
STAFFORD KANSAS

PLUGGING REPORT

To: Seigfried - Rooney - Thomas
c/o Wally Borgeson
Box 324,
Great Bend, Kansas

LEASE: H. W. McClean Well No. 1, NE NE NW 28-16-25, Ness County Kansas

Orderd By: Wally Borgeson

Total Depth 4547'

P. B. D. 4530'

Perforation 4523-30'

5 1/2" - 1 1/4" J-55 Casing, Set @ 4540' with 150 Sacks Cement

8-5/8" Casing Set @ 280' Cement Circulated.

P. B. 4530 to 4487' cement 10 sacks
4487' to 275' Heavy Mud Circulated
275' to 265' Rock Bridge
265' to 220' Cement with 15 sacks
220' to 40' Heavy Mud
40' to 35' rock bridge
25' to bottom of cellar 10 sacks cement

Plugging instructions by: Mr. Warren Horner
State Plugger,
Great Bend, Kansas

K-O CASING PULLING COMPANY
PERMIT NO. 206

BY: *Albert M. Dittges*
Albert M. Dittges, Supt.
Stafford, Kansas

