


STATE OF KANSAS
STATE CORPORATION COMMISSION

WELL PLUGGING RECORD

Give All Information Completely
Make Required Affidavit
Mail or Deliver Report to:
Conservation Division
State Corporation Commission
211 No. Broadway
Wichita, Kansas

Ness County. Sec. 28 Twp. 16S Rge. 25 (E) W (W)
Location as "NE/CNW/SW" or footage from lines SE SE SW
Lease Owner Kaiser and Francis
Lease Name Hamlin Est. Well No. 1
Office Address _____
Character of Well (completed as Oil, Gas or Dry Hole) Oil
Date well completed _____ 19____
Application for plugging filed _____ 19____
Application for plugging approved _____ 19____
Plugging commenced Sept. 25 1957
Plugging completed Sept. 28 1957
Reason for abandonment of well or producing formation Insuficent production

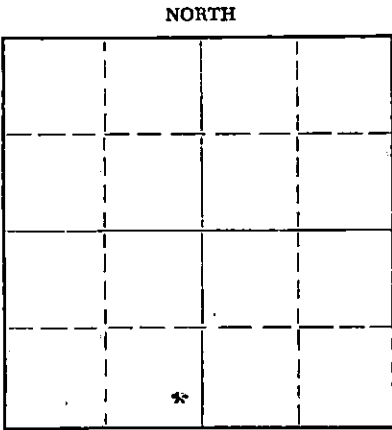

Locate well correctly on above
Section Plat

If a producing well is abandoned, date of last production Sept. 24 1957
Was permission obtained from the Conservation Division or its agents before plugging was commenced? YES

Name of Conservation Agent who supervised plugging of this well Russell Brundage
Producing formation _____ Depth to top _____ Bottom _____ Total Depth of Well 4489 Feet
Show depth and thickness of all water, oil and gas formations.

OIL, GAS OR WATER RECORDS

CASING RECORD

FORMATION	CONTENT	FROM	TO	SIZE	PUT IN	PULLED OUT
				8 5/8	225'	none
				5 1/2	4486'	3478'

Describe in detail the manner in which the well was plugged, indicating where the mud fluid was placed and the method or methods used in introducing it into the hole. If cement or other plugs were used, state the character of same and depth placed, from _____ feet to _____ feet for each plug set.

Plug back with sand from 4486' to 4445' and dumped 5 sx. cement from 4445' to 4405'. Pulled 5 1/2 casing to 1100' and circulated 35 sx. gel mud. Pulled 5 1/2 casing to 750' and pumped in 100 sx. cement. Pulled 5 1/2 casing to 450' and pumped in 75 sx. cement. Checked cement fillup with measuring line at 32'. Mudded from 32' to 20' and set 5' rock bridge from 20' to 15'. Dumped 5 sx. cement from 15' to base celler.

(If additional description is necessary, use BACK of this sheet)

Name of Plugging Contractor Ace Pipe Pulling Co.
Address Box 304 Great Bend, Ks.

STATE OF Kansas, COUNTY OF Barton, ss.
Kaiser-Francis (employee of owner) or (owner or operator) of the above-described well, being first duly sworn on oath, says: That I have knowledge of the facts, statements, and matters herein contained and the log of the above-described well as filed and that the same are true and correct. So help me God.

(Signature) [Signature]

SUBSCRIBED AND SWORN TO before me this 30 day of September, 1957

[Signature]
(Address)
Wichita, Kansas
Notary Public.

My commission expires _____

PLUGGING
FILE SEC 28 T 16 R 25 W
BOOK PAGE 48 LINE 15

RECEIVED
STATE CORPORATION COMMISSION

OCT 4 - 1957

CONSERVATION DIVISION
Wichita, Kansas

BARNETT DRILLING, INC.
 LOG OF HANLIN INVESTMENT CO. NO. 1
 SE SE SW OF SECTION 28-16-25
 NESS COUNTY, KANSAS.

Commenced: 6-14-57

Completed: 6-29-57

Formation	From	To	Remarks
Shale	-0-	50	Set 8-5/8" Casing at 225 feet; Cemented with 150 sacks.
Sand	50	60	
Shale and Shells	60	225	
Shale and Shells	225	1060	
Sand and Shale	1060	1240	
Shale and Shells	1240	1360	
Sand	1360	1590	
Shale	1590	1880	
Anhydrite	1880	1910	
Shale	1910	1980	
Shale and Shells	1980	2535	
Shale	2535	2625	
Lime	2625	3040	
Lime and Shale	3040	3255	
Lime	3255	3580	
Lime and Shale	3580	3680	
Lime	3680	4487	Set 5 1/2" Casing at 4485 1/2 feet; Cemented with 150 sacks.
Total Depth		4487	

CERTIFICATE

I, Louise Burnett, of Barnett Drilling, Inc., certify to the best of my knowledge and belief, that the foregoing is a true and correct log of Hanlin Investment Co. No. 1, located in the SE SE SW of Section 28-16-25, Ness County, Kansas.

Louise Burnett

Subscribed and sworn to by and before me in and for the County of Sedgwick, State of Kansas this 30th day of August, 1957.

Mildred J. Willis

PLUGGING

FILE SEC. 28 T. 16 R. 25W
 BOOK PAGE 4a LINE 15