


STATE OF KANSAS  
STATE CORPORATION COMMISSION

Form CP-4

Give All Information Completely  
Make Required Affidavit  
Mail or Deliver Report to:  
Conservation Division  
State Corporation Commission  
212 No. Market  
Wichita, Kansas

WELL PLUGGING RECORD

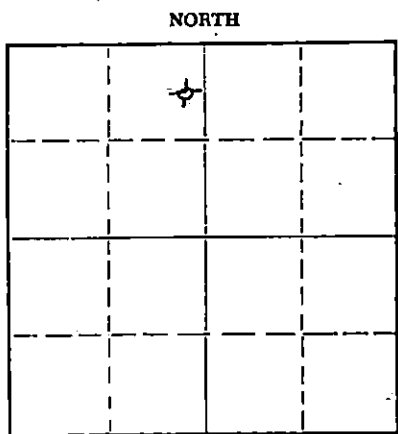

Locate well correctly on above Section Plat

Ness County, Sec. 10 Twp. 16S Rge. 21 (W)  
Location as "NE/CNW/SW" or footage from lines. Ctr. E/2 NE/4 NW/4  
Lease Owner Champlin Petroleum Company  
Lease Name Harms-Kendall "B" #1 Well No. 1  
Office Address P. O. Box 308, Ellinwood, Kansas  
Character of Well (completed as Oil, Gas or Dry Hole) Dry Hole  
Date well completed January 5 19 68  
Application for plugging filed January 5 19 68  
Application for plugging approved (Verbal) January 5 19 68  
Plugging commenced January 5 19 68  
Plugging completed January 6 19 68

Reason for abandonment of well or producing formation \_\_\_\_\_  
If a producing well is abandoned, date of last production \_\_\_\_\_ 19 \_\_\_\_\_  
Was permission obtained from the Conservation Division or its agents before plugging was commenced? yes

Name of Conservation Agent who supervised plugging of this well Leo Massey  
Producing formation \_\_\_\_\_ Depth to top \_\_\_\_\_ Bottom \_\_\_\_\_ Total Depth of Well 4286 Feet  
Show depth and thickness of all water, oil and gas formations.

OIL, GAS OR WATER RECORDS

CASING RECORD

FORMATION	CONTENT	FROM	TO	SIZE	PUT IN	PULLED OUT
				8 5/8" OD	250'	None
RECEIVED STATE CORPORATION COMMISSION JAN 15 1968 CONSERVATION DIVISION Wichita, Kansas						

Describe in detail the manner in which the well was plugged, indicating where the mud fluid was placed and the method or methods used in introducing it into the hole. If cement or other plugs were used, state the character of same and depth placed, from \_\_\_\_\_ feet to \_\_\_\_\_ feet for each plug set.

Filled hole with heavy rotary mud from 4286' TD. to 725' and pumped in 70 sacks of cement at 725' then filled hole with heavy mud to 240' and pumped in 20 sacks of cement then filled hole with heavy mud to 40' and made a bridge with 1 sack of cotton seed hulls that held the Kelly and then filled hole to surface using 10 sacks of cement.

All cement furnished by Halliburton and was 50/50 posmix with 6% gel.

(If additional description is necessary, use BACK of this sheet)  
Name of Plugging Contractor Garvey Drilling Company  
Address Rt. #2, Great Bend, Kansas

STATE OF Kansas, COUNTY OF Barton, ss.  
J. W. Meyers (employee of owner) or (operator) of the above-described

well, being first duly sworn on oath, says: That I have knowledge of the facts, statements, and matters herein contained and the log of the above-described well as filed and that the same are true and correct. So help me God.

(Signature) J. W. Meyers, Dist. Opt's. Mgr.  
P. O. Box 308, Ellinwood, Kansas  
(Address)

SUBSCRIBED AND SWORN to before me this 11th day of January, 19 68

My commission expires 5/22/70 Notary Public.

# WELL LOG

15.135.20101.00.00

COMPANY **Champlin Petroleum Company**

SEC. 10 T. 16S R. 21W

FARM **Harms - Kendall**

NO. **B-1**

LOC. **E/2 NE NW**

TOTAL DEPTH **4286'**


COUNTY **Ness**

COMM. **12-22-67**

COMP. **1-6-68**

CONTRACTOR **Garvey Drilling Company**

CASING **8 5/8" @ 250' w/200 SX**

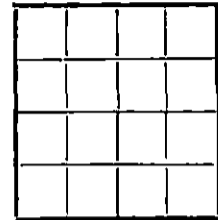

ELEVATION

PRODUCTION **D & A**

FIGURES INDICATE BOTTOM OF FORMATIONS

- 100' Post Rock
- 500' Shale
- 875' Sand
- 1090' Shale and Sand
- 1100' Shale
- 1205' Sand
- 1587' Shale
- 1654' Red Bed and Shale
- 1688' Anhydrite
- 1730' Shale and Red Bed
- 2390' Shale and Lime
- 2490' Lime and Shale
- 2570' Shale and Lime
- 3645' Lime and Shale
- 3900' Lime
- 4050' Lime and Shale
- 4200' Lime
- 4211' Lime and Shale
- 4213' Sand and Pyrite
- 4218' Lime
- 4245' Lime and Shale
- 4286' Lime and Chert
- 4286' RTD

RECEIVED  
STATE CORPORATION COMMISSION  
JAN 31 1968  
CONSERVATION DIVISION  
Wichita, Kansas

State of Kansas

County of Barton

SS

I, Sam N. Stephens of Garvey Drilling Company

upon oath state the above and foregoing is a true and correct copy of the log of the Harms - Kendall B-1 well.

Sam N. Stephens

Subscribed and sworn to before me this 23rd day of January 19 68

My Commission Expires: November 5th, 1969

Richard A. Boys  
NOTARY PUBLIC



January 9, 1968

RECEIVED  
STATE CORPORATION COMMISSION  
JAN 11 1968  
CONSERVATION DIVISION  
Wichita, Kansas

State Corporation Commission  
Conservation Division  
212 N. Market  
Wichita, Kansas 67202

Re: Champlin  
Harms-Kendall B #1  
Ness County, Kansas

Attention: Mr. S. S. Greider

Dear Sir:

I am returning your invoice covering the plugging assessment for the subject well.

The reason I am returning this invoice is because the total depth of this rotary dry hole was 4286' and I felt you may wish to re-invoice us for this assessment.

Also enclosed is the authority to plug this well and our well plugging application for this well.

Very truly yours,

A handwritten signature in cursive script, appearing to read 'N. K. Stivers'.

N. K. Stivers  
District Clerk

NKS:ds

Enclosure