


STATE OF KANSAS  
STATE CORPORATION COMMISSION

WELL PLUGGING RECORD

Give All Information Completely  
Make Required Affidavit  
Mail or Deliver Report to:  
Conservation Division  
State Corporation Commission  
P. O. Box 17027  
Wichita, Kansas 67217  
NORTH

*206*

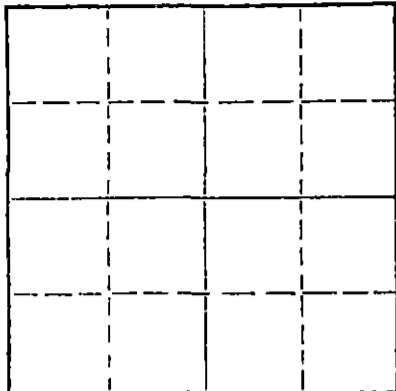

Locate well correctly on above  
Section Plat

Pawnee County, Sec. 5 Twp. 20S Rge. 16W (E) (W)  
Location as "NE/CNW/SW" or footage from lines: NE of C of SW SW SE  
Lease Owner: Murfin Drilling Company  
Lease Name: Oetken #1 Well No. \_\_\_\_\_  
Office Address: Russell, Kansas 67665  
Character of Well (completed as Oil, Gas or Dry Hole) \_\_\_\_\_  
Date well completed \_\_\_\_\_ 19\_\_\_\_  
Application for plugging filed \_\_\_\_\_ 19\_\_\_\_  
Application for plugging approved \_\_\_\_\_ 19\_\_\_\_  
Plugging commenced 7/20/72 \_\_\_\_\_ 19\_\_\_\_  
Plugging completed 7/22/72 \_\_\_\_\_ 19\_\_\_\_  
Reason for abandonment of well or producing formation depleted.

If a producing well is abandoned, date of last production \_\_\_\_\_ 19\_\_\_\_  
Was permission obtained from the Conservation Division or its agents before plugging was commenced? yes

Name of Conservation Agent who supervised plugging of this well Massey  
Producing formation \_\_\_\_\_ Depth to top \_\_\_\_\_ Bottom \_\_\_\_\_ Total Depth of Well 3865 Feet  
Show depth and thickness of all water, oil and gas formations.

OIL, GAS OR WATER RECORDS

CASING RECORD

FORMATION	CONTENT	FROM	TO	SIZE	PUT IN	PULLED OUT
				8-5/8	1120	none
				5 1/2	3864	2896'

Describe in detail the manner in which the well was plugged, indicating where the mud fluid was placed and the method or methods used in introducing it into the hole. If cement or other plugs were used, state the character of same and depth placed, from \_\_\_\_\_ feet to \_\_\_\_\_ feet for each plug set.

Ran sand to 3780' and dumped 5 sacks of cement. Loaded hole, shot pipe at 2906', pulled 88 joints. Set rock bridge at 375 to 359' and dumped 5 yards ready mix.

PLUGGING COMPLETE.

RECEIVED  
STATE CORPORATION COMMISSION  
AUG 3 1972  
CONSERVATION DIVISION  
Wichita, Kansas

(If additional description is necessary, use BACK of this sheet)  
Name of Plugging Contractor KNIGHT CASING PULLING CO., INC.  
Address CHASE, KANSAS

STATE OF KANSAS, COUNTY OF RICE, ss.  
NOEL J. KNIGHT (employee of owner) or (owner or operator) of the above-described

well, being first duly sworn on oath, says: That I have knowledge of the facts, statements, and matters herein contained and the log of the above-described well as filed and that the same are true and correct. So help me God.

(Signature) Noel Knight  
CHASE, KANSAS  
(Address)

SUBSCRIBED AND SWORN TO before me this 24th day of July, 19 72

My commission expires

MARGARET MELCHER  
NOTARY PUBLIC  
Rice County, Kansas  
My Commission Expires  
Feb. 15, 1975

Notary Public.

# WELL LOG

15.145.20099.0000

COMPANY **Murfin Drilling Company**  
FARM **Oetken** NO. **1**

SEC. 5 T. 20S R. 16W  
LOC. 150' NE of C SW SW SE

RID. NO.  
TOTAL DEPTH **3865 feet**  
COMM. **January 22, 1969** COMP. **February 1, 1969**  
CONTRACTOR **H-30, Inc.**

COUNTY **Pawnee**  
**KANSAS**



CASING  
20 10  
15 8 5/8" 1120'  
12 6'  
13 5 1/2" 3864'

ELEVATION **2064 DF**

PRODUCTION

FIGURES INDICATE BOTTOM OF FORMATIONS

Surface Soil & Sand	68
Shale	510
Sand	640
Shale	660
Red Bed & Shale	1030
Shale	1108
Anhydrite	1137
Shale	1825
Shale & Lime	3316
Lime	3452
Lime & Shale	3563
Lime	3865

RECEIVED  
STATE CORPORATION COMMISSION  
JUN 26 1972  
CONSERVATION DIVISION  
Wichita, Kansas

State of Kansas  
County of Sedgwick } ss:

I, James R. Daniels of the Murfin Drilling Company

upon oath state that the above and foregoing is a true and correct copy of the log of the Oetken #1 well.

Subscribed and sworn to before me this 23rd day of June 1972

James R. Daniels  
James R. Daniels

My Commission Expires:

DOLORES B. COADY  
STATE NOTARY PUBLIC  
SEDGWICK COUNTY, KANSAS  
Comm. Expires Mar. 7, 1975

Dolores B. Coady  
Dolores B. Coady  
NOTARY PUBLIC