

STATE OF KANSAS
STATE CORPORATION COMMISSION


WELL PLUGGING RECORD

OR
FORMATION PLUGGING RECORD

Strike out upper line when reporting plugging of formations.

Give All Information Completely
Make Required Affidavit
Mail or Deliver Report to:
Conservation Division
State Corporation Commission
800 Bittling Building
Wichita, Kansas

Pawnee County. Sec. 5S Twp. 20S Rge. 16 (E) (W)
Location as "NE 1/4 NW 1/4 SW 1/4" or footage from lines. Cen. NE NW SE
Lease Owner Ben F. Brack
Lease Name Rankin Well No. 3
Office Address 205 Brown Building, Wichita, Kansas
Character of Well (completed as Oil, Gas or Dry Hole) dry
Date well completed 3-6-47 19
Application for plugging filed 19
Application for plugging approved 19
Plugging commenced 19
Plugging completed 19
Reason for abandonment of well or producing formation dry hole
If a producing well is abandoned, date of last production 19
Was permission obtained from the Conservation Division or its agents before plugging was commenced? yes

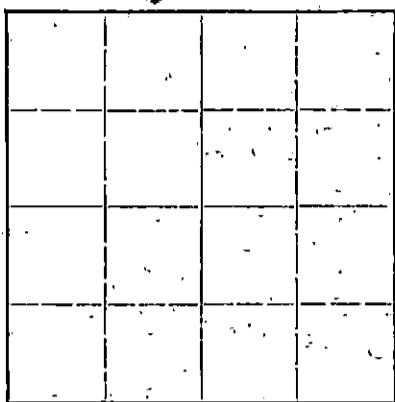

Locate well correctly on above Section Plat

Name of Conservation Agent who supervised plugging of this well
Producing formation none Depth to top Bottom Total Depth of Well 3825' Feet
Show depth and thickness of all water, oil and gas formations.

OIL, GAS OR WATER RECORDS CASING RECORD

Formation	Content	From	To	Size	Put In	Pulled Out
Shale Shells Red-Red Anhydrite		0	1077'	8 1/2" OD	1077'	None

Describe in detail the manner in which the well was plugged, indicating where the mud fluid was placed and the method or methods used in introducing it into the hold. If cement or other plugs were used, state the character of same and depth placed, from feet to feet

feet for each plug set.
Hole Loaded with Heavy Mud To 360'
Halliburton Plug set at 360 - 15' cement.
Hole Loaded To 45' with Mud - Halliburton Plug set.
15' set cement on top of Plug

STATE CORPORATION COMMISSION
JUL 31 1947
CONSERVATION DIVISION

(If additional description is necessary, use BACK of this sheet)
Correspondence regarding this well should be addressed to Brack Oil Company, Inc.
Address 205 Brown Bldg., Wichita, Kansas

STATE OF Kansas COUNTY OF Sedgewick, ss.
Seland E Brack (employee of owner) or (owner) of the above-described well,
being first duly sworn on oath, says: That I have knowledge of the facts, statements, and matters herein contained and the log of the above-described well as filed and that the same are true and correct. So help me God.

(Signature) Seland E Brack
205 Brown Bldg Wichita, Kansas (Address)

SUBSCRIBED AND SWORN to before me this 31 day of July 1947
Ludlow Stern Notary Public.

My commission expires June 6, 1949

PLUGGING
FILE SEC 5 T 20 R 16 W
BOOK PAGE 102 LINE 5

WELL LOG

BRACK DRILLING COMPANY
205 Brown Building
Wichita, Kansas

Ben F. Brack
Rankin No. 3

Sec. NE NW SE S5-20S-16W.
Pawnee County, Kansas

TOTAL DEPTH: 3825'
Comm: 2-15-47 Comp: 3-6-47

Cellar	5
surface clay & sand	55
shale & shells	275
shale & shells & sand & red bed	700
shale & sand streaks	840
shale, shells & red bed	975
red bed-shale & iron	1050
shale & sand streaks	1073
anhydrite	1077
anhydrite	1100
shale & shells	1235
shale, shells & sand streaks	1535
shale & lime streaks, salt	1700
shale & lime	1850
shale & lime	1990
shale, lime streaks	2050
lime	2065
lime & shale	2170
shale & sandy lime	2214
shale & lime	2315
lime & shale	2390
lime	2420
shale & shell	2430
shale & lime	2505
lime & shale	2610
lime & shale	2645
lime & shale	2715
lime & shale	2790
shale & shells	2825
lime & shale	2830
shale & lime	2945
lime & shale	3030
lime & shale streaks	3108
lime & shale	3143
broken lime	3205
lime	3255
lime & shale	3330
broken lime & shale	3368
lime & shale	3430
lime	3434
lime & shale	3499
lime	3515
lime	3563 (soft lime, 3528 to 3541 - no odor)
lime & shale streaks	3598
lime	3639
lime	3662
lime	3688
lime broken	3710
lime & shale	3730
lime & shale	3750
cong. cherty	3765
dolomite arbuttle cherty	3779
lime	3805
lime	3825
TOTAL DEPTH	3825

STATE OF KANSAS
COMMISSIONER OF GEOL. & SURV.
MAR 13 1947
CORRECTED
RECORDED

To the best of my knowledge the above is a true and correct record of the formations and depths at which found.

BRACK DRILLING COMPANY

WITNESS: _____

DATED: _____

PLUGGING
FILE SEC 5 T 20 S R 16 W
BOOK PAGE 102 LINE 5