


STATE OF KANSAS
STATE CORPORATION COMMISSION

Give All Information Completely
Make Required Affidavit
Mail or Deliver Report to:
Conservation Division
State Corporation Commission
800 Bittling Building
Wichita, Kansas

WELL PLUGGING RECORD

NORTH

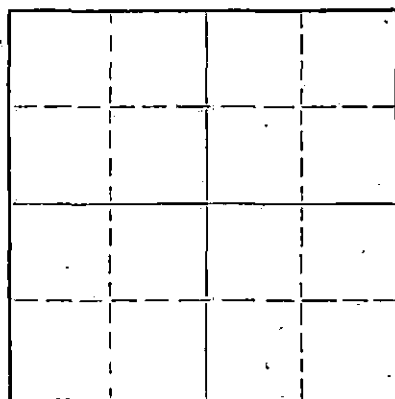

Locate well correctly on above
Section Plat

Pawnee County, Sec. 5 Twp. 20 Rge. 16 (K) (W)
Location as "NE/CNW/SW" or footage from lines Center SW NW SE
Lease Owner Ben F. Brack
Lease Name Rankin Well No. 2
Office Address 309 Brown Bldg., Wichita 2, Kansas
Character of Well (completed as Oil, Gas or Dry Hole) Oil
Date well completed 2-14-47 19
Application for plugging filed 7-14-52 19
Application for plugging approved 7-14-52 19
Plugging commenced 7-14-52 19
Plugging completed 7-14-52 19
Reason for abandonment of well or producing formation oil depleted

If a producing well is abandoned, date of last production March 1 19 52
Was permission obtained from the Conservation Division or its agents before plugging was commenced? Yes, verbally

Name of Conservation Agent who supervised plugging of this well M. A. Rives, Box 148, Pratt, Kansas
Producing formation Arbuckle Depth to top 3738' Bottom _____ Total Depth of Well 3764' Feet
Show depth and thickness of all water, oil and gas formations.

OIL, GAS OR WATER RECORDS

CASING RECORD

FORMATION	CONTENT	FROM	TO	SIZE	PUT IN	PULLED OUT
Surface clay, shale, shells, sand, Red bed, & Anhydrite		0'	1083'	8 5/8"	1086'	
Arbuckle		0'	3743'	5 1/2"	3745'	2317.84'

Describe in detail the manner in which the well was plugged, indicating where the mud fluid was placed and the method or methods used in introducing it into the hole. If cement or other plugs were used, state the character of same and depth placed, from _____ feet to _____ feet for each plug set.

From 3764' to 3735' Sand
" 3735' to 3700' Cement (5 sacks)
" 3700' to 300' Heavy mud
" 300' to 290' Permanent Rock Bridge
" 290' to 230' Cement (20 sacks)
" 230' to 35' Heavy mud.
" 35' to 30' Rock Bridge
" 30' to Bottom of cellar - cement (10 sacks)

(If additional description is necessary, use BACK of this sheet)

Name of Plugging Contractor Ben F. Brack Oil Company, Inc., 309 Brown Bldg.
Address Wichita 2, Kansas

STATE OF KANSAS COUNTY OF SEDGWICK, ss.

Henry B. Brack (employee of owner) or (owner or operator) of the above-described well, being first duly sworn on oath, says: That I have knowledge of the facts, statements, and matters herein contained and the log of the above-described well as filed and that the same are true and correct. So help me God.

(Signature) [Signature]
309 Brown Bldg., Wichita 2, Kansas
(Address)

SUBSCRIBED AND SWORN TO before me this 15th day of July, 1952

My commission expires June 11, 1955

[Signature]
Notary Public.

PLUGGING
FILE SEC 5 T 20 R 16
DATE 29 JUL 54

RECEIVED
STATE CORPORATION COMMISSION
JUL 26 1952
CONSERVATION DIVISION
Wichita, Kansas

WELL LOG

15.145.01228.0000

BRACK DRILLING COMPANY
205 Brown Building
Wichita, Kansas

Ben F. Brack
Rankin No. 2

Center SW NW/SE Section 5-208, R16W,
Pawnee County, Kansas

TOTAL DEPTH:	3745'
Comm: 1-27-47	Comp. 2-14-47
Cellar	5
surface clay	30
shale & shells	105
shale-shell & sand	525
sand	628
sand streaks & shale red bed	698
red bed, shale & shells	888
anhydrite	1083
anhydrite	1200
shale & shell	1410
salt	1500
shale & salt	1775
sand lime & shale	1915
lime	1968
lime	2015
lime & shale	2055
lime	2058
shale & lime	2230
lime & shale	2296
lime & shale streaks	2363
lime & shale	2428
lime & shale	2520
lime & shale	2575
lime & shale	2663
lime & shale	2740
shale shell & lime streaks	2790
shale & lime	2877
shale & lime	2945
lime & shale	3000
lime & shale	3045
lime & shale	3115
broken lime	3160
lime	3210
lime & shale	3260
broken lime	3265
lime & shale	3288
lime & shale	3358
lime & shale	3398
lime broken	3400
shale & lime shell	3434
K. C. Lime	3438
lime	3470
lime	3508
lime	3552
lime	3574
cherty lime & shale	3620
lime & shale	3655
lime & shale	3694
lime & shale	3728
lime	3738
lime & green shale	3745
TOTAL DEPTH	3745

WITNESS:

Ben F. Brack

DATED:

2-16-47



To the best of my knowledge the
above is a true and correct record
of the formations and depths at
which found.

BRACK DRILLING COMPANY

Ben F. Brack

STATE CORPORATION

JUL 26 1947

CONSERVATION DIVISION
Wichita, Kansas

PLUGGING

REC-57207(6)

NO. 29 LINE 49