


STATE OF KANSAS  
STATE CORPORATION COMMISSION

WELL PLUGGING RECORD

Give All Information Completely  
Make Proper Affidavit  
Mail or Report to:  
Conservation Division  
State Corporation Commission  
800 Bitting Building  
Wichita, Kansas

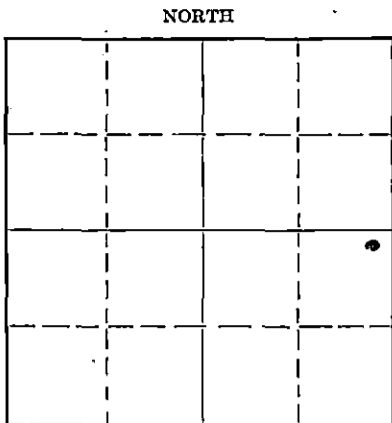

Locate well correctly on above  
Section Plat

Location as "NE/CNW/SW" or footage from lines Pawnee County, Sec 11 Twp 20 Rge 16 (E) (W)  
Lease Owner Campbell & Huber  
Lease Name Wichitron B Well No. 1  
Office Address \_\_\_\_\_  
Character of Well (completed as Oil, Gas or Dry Hole) \_\_\_\_\_  
Date well completed Nov 18 1946 19\_\_\_\_  
Application for plugging filed Feb 14 - 1952  
Application for plugging approved 2-14 1952  
Plugging commenced 2-14 1952  
Plugging completed 2-14 1952  
Reason for abandonment of well or producing formation Watered out  
If a producing well is abandoned, date of last production July 1951  
Was permission obtained from the Conservation Division or its agents before plugging was commenced? yes

Name of Conservation Agent who supervised plugging of this well C. N. Stough  
Producing formation Artificial Depth to top 3697 Bottom 3756 Total Depth of Well 3756 Feet  
Show depth and thickness of all water, oil and gas formations.

OIL, GAS OR WATER RECORDS

CASING RECORD

Formation	Content	From	To	Size	Put In	Pulled Out
				<u>8 5/8</u> <u>4 1/2</u>	<u>1000</u> <u>3756</u>	<u>none</u> <u>850'</u>

Describe in detail the manner in which the well was plugged, indicating where the mud fluid was placed and the method or methods used in introducing it into the hole. If cement or other plugs were used, state the character of same and depth placed, from \_\_\_\_\_ feet to \_\_\_\_\_ feet for each plug set.

Cemented from 3756 to 3714 mudded to 850 cement plug from 850 to 840 mudded from 840 to 850 cement plug from 850 to 830 mudded to 80 cement plug to surface of

(If additional description is necessary, use BACK of this sheet)  
Correspondence regarding this well should be addressed to Campbell & Huber 317 Beacon Bldg  
Address Wichita, Kans

STATE OF Kansas, COUNTY OF Pawnee, ss.

\_\_\_\_\_ (employee of owner) or (owner or operator) of the above-described well, being first duly sworn on oath, says: That I have knowledge of the facts, statements, and matters herein contained and the log of the above-described well as filed and that the same are true and correct. So help me God.

3-12-52 (Signature) W Campbell  
1415 Jackson St Great Bend, Kas (Address)

SUBSCRIBED AND SWORN to before me this 11th day of March, 1952

My commission expires 9-29-54  
Nadine Williams Notary Public.

22-7377-S 4-40-10M

PLUGGING  
FILE SEC-11-T-20H-66L  
BOOK PAGE 147 LINE 37

COMPANY: Campbell & Kuhn  
 LEASE: Wickstrom B-1  
 COUNTY: Pawnee  
 CONTRACTOR: Campbell Drilling Company  
 WELL COMMENCED: October 16, 1946  
 WELL COMPLETED: November 4, 1946

0-110	Cellar
110-660	Clay and shells
660-810	Shale and shells
810-930	Red Bed
930-1007	Red bed and shells
1007-1015	Anhydrite - T.D. - Ran surface pipe
1015-1440	Shale and shells
1440-1700	Salt and shale
1700-1755	Shale and shells
1755-1995	Shale and lime
1995-2090	Sandy lime and shale
2090-2785	Shale and lime
2785-2915	Shale
2915-2960	Shale and lime
2960-3000	Lime
3000-3021	Shale
3021-3050	Lime
3050-3110	Lime and shale
3110-3185	Broken lime and shale
3185-3318	Lime
3318-3376	Lime and shale
3376-3429	Shale
3429-3437	Lime
3437-3443	Broken lime
3443-3639	Lime
3639-3701	Shale and lime
3701-3760	Lime --- T.D.

Hole full of water at 3760'.  
 Well plugged off at 3760' with 8' cement plug.  
 Well perforated from 3745½' to 3749' with 18 holes.  
 Well made about 1,000,000' of gas, some oil, and barrel of water per hour at 3749'.  
 Well plugged back to 3746' with plastic perforated from 3724' to 3726' with 35 holes.  
 Well made 5,000,000' of gas.  
 Estimated and shut in.

**PLUGGING**  
 FILE SEC 16 T 20 R 16  
 PAGE PAGE 46 LINE 37

CC. MAR 12 1952  
 WICKSTROM