

STATE OF KANSAS  
STATE CORPORATION COMMISSION

Form CP-4


WELL PLUGGING RECORD  
WASHDOWN JOB

Give All Information Completely  
Make Required Affidavit  
Mail or Deliver Report to:  
Conservation Division  
State Corporation Commission  
211 No. Broadway  
Wichita, Kansas

Pawnee County, Sec. 31 Twp. 20S Rge. 16 (E) W (W)

Location as "NE/CNW&SW&" or footage from lines NE/4 NE/4 SE/4  
Lease Owner Birmingham-Bartlett Drilling Co.  
Lease Name Finger "A" Well No. 1  
Office Address 300 Kaufman Building, Wichita, Kansas 67202  
Character of Well (completed as Oil, Gas or Dry Hole) Dry Hole  
Date well completed Completed Washdown - November 5, 1964  
Application for plugging filed (verbal) November 5, 1964  
Application for plugging approved (verbal) November 5, 1964  
Plugging commenced November 5, 1964  
Plugging completed November 5, 1964  
Reason for abandonment of well or producing formation Dry Hole

NORTH

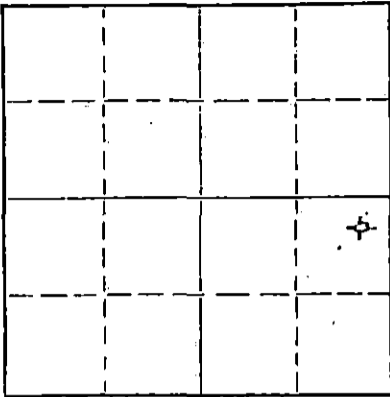

Locate well correctly on above  
Section Plat

If a producing well is abandoned, date of last production -----19--  
Was permission obtained from the Conservation Division or its agents before plugging was commenced? Yes

Name of Conservation Agent who supervised plugging of this well Eldon Petty New  
Producing formation \_\_\_\_\_ Depth to top \_\_\_\_\_ Bottom \_\_\_\_\_ Total Depth of Well 3896 Feet  
Show depth and thickness of all water, oil and gas formations.

OIL, GAS OR WATER RECORDS

CASING RECORD

FORMATION	CONTENT	FROM	TO	SIZE	PUT IN	PULLED OUT
(Surface casing set by Ben Hyde in 1952)		0	1078'	8"	1078'	none
(Arbuckle well abandoned as a dry hole at that time.)						

Describe in detail the manner in which the well was plugged, indicating where the mud fluid was placed and the method or methods used in introducing it into the hole. If cement or other plugs were used, state the character of same and depth placed, from \_\_\_\_\_ feet to \_\_\_\_\_ feet for each plug set.

Bottom plug set at 1070' with 20 sacks cement mixed and poured through drill pipe. Middle plug set at 500' with 20 sacks cement mixed and poured through drill pipe. Top plug set at 35' with 1/4 sack hulls and 10 sacks cement.

RECEIVED  
STATE CORPORATION COMMISSION

NOV 10 1964

CONSERVATION DIVISION  
Wichita, Kansas

(If additional description is necessary, use BACK of this sheet)  
Name of Plugging Contractor Birmingham-Bartlett Drilling Co.  
Address 300 Kaufman Building-Wichita, Kansas 67202

STATE OF KANSAS COUNTY OF SEDGWICK  
Richard Hindery, partner of Birmingham-Bartlett Drilling Co., ss. owner and contractor  
(employee of owner) or (owner or operator) of the above-described well, being first duly sworn on oath, says: That I have knowledge of the facts, statements, and matters herein contained and the log of the above-described well as filed and that the same are true and correct. So help me God. BIRMINGHAM-BARTLETT DRILLING CO.

(Signature) By Richard Hindery Partner  
300 Kaufman Building Wichita, Kansas 67202  
(Address)

SUBSCRIBED AND SWORN TO before me this 9th day of November, 19 64.

My commission expires October 2, 1966.

Beverly Larson  
Beverly Larson  
Notary Public.

FINGER "A" NO. 1 WELL  
WASHDOWN OF OLD DRY HOLE

LOCATION: NE/4 NE/4 SE/4 Section 31-203-16W Pawnee County, Kansas  
 BEGAN WASHDOWN: 11-3-64  
 PLUGGED WELL: 11-5-64

OWNER, OPERATOR and CONTRACTOR: Birmingham-Bartlett Drilling Co. 300 Kaufman Building Wichita, Kansas 67202

SURFACE CASING: 8" surface casing set at 1078' in 1952 when this well was originally drilled by Ben C. Hyde as a dry hole.

OIL STRING: None set. Dry hole. Plugged November 5, 1964.

LOG

0 - 300	Cement
3891	Washed down
3896	Line
3896	New Rotary Total Depth

The undersigned, Richard Hindery, one of the partners of Birmingham-Bartlett Drilling Co., hereby certifies that the above is a true and correct log of the washdown of the Finger "A" No. 1 Well as shown in the daily drilling reports.

BIRMINGHAM-BARTLETT DRILLING CO.

By Richard Hindery  
Richard Hindery, Partner

Subscribed and sworn to before me this 9th day of November, 1964.

Beverly Larson  
Beverly Larson, Notary Public  
My commission expires October 2, 1966.

**RECEIVED**  
STATE CORPORATION COMMISSION  
NOV 10 1964  
CONSERVATION DIVISION  
Wichita, Kansas