


WELL PLUGGING RECORD

Give All Information Completely  
Make Required Affidavit  
Mail or Deliver Report to:  
Conservation Division  
State Corporation Commission  
800 Bittling Building  
Wichita, Kansas

Pawnee County. Sec. 29 Twp. 20 Rge. 16 (E) W (W)  
Location as "NE/CNW $\frac{1}{4}$ /SW $\frac{1}{4}$ " or footage from lines SW SE SE  
Lease Owner Imperial Drilling Company, Inc., Wichita, Kans.  
Lease Name FOX Well No. 1  
Office Address 903 Union National Bank Building, Wichita, Kans.  
Character of Well (completed as Oil, Gas or Dry Hole) Dry Hole  
Date well completed July 4 1953  
Application for plugging filed July 4 1953  
Application for plugging approved July 5 1953  
Plugging commenced July 5 1953  
Plugging completed July 5 1953  
Reason for abandonment of well or producing formation oil in commercial quantities not found  
If a producing well is abandoned, date of last production \_\_\_\_\_ 19\_\_\_\_  
Was permission obtained from the Conservation Division or its agents before plugging was commenced? yes

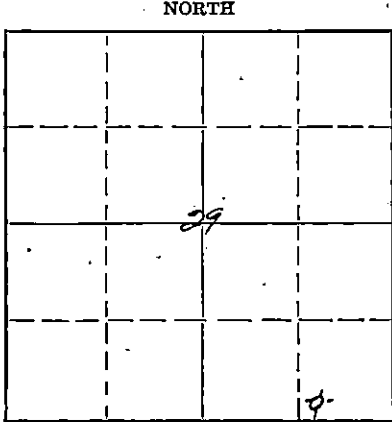

Locate well correctly on above Section Plat

Name of Conservation Agent who supervised plugging of this well M. A. Rives, Box 148, Pratt, Kansas  
Producing formation \_\_\_\_\_ Depth to top \_\_\_\_\_ Bottom \_\_\_\_\_ Total Depth of Well 3837' Feet  
Show depth and thickness of all water, oil and gas formations.

OIL, GAS OR WATER RECORDS.

CASING RECORD

Formation	Content	From	To	Size	Put In	Pulled Out
				8 5/8"	315'	none

Describe in detail the manner in which the well was plugged, indicating where the mud fluid was placed and the method or methods used in introducing it into the hole. If cement or other plugs were used, state the character of same and depth placed, from \_\_\_\_\_ feet to \_\_\_\_\_ feet for each plug set.

Filled hole with mud to 310'.  
Put in plug. Filled hole with cement from 310' to surface with 100 sacks cement.


7-9-53  
CONS. DIV.

(If additional description is necessary, use BACK of this sheet)  
Name of Plugging Contractor Imperial Drilling Company, Inc.  
Address 903 Union National Bank Building, Wichita, Kansas

STATE OF Kansas, COUNTY OF Sedgwick, ss.  
Raymond L. Bacon (employee of owner) or (owner or operator) of the above-described well, being first duly sworn on oath, says: That I have knowledge of the facts, statements, and matters herein contained and the log of the above-described well as filed and that the same are true and correct. So help me God IMPERIAL DRILLING COMPANY, INC.  
(Signature) BY: Raymond L. Bacon Vice-Pres.  
903 Union National Bank Building  
Wichita 2, Kansas (Address)

SUBSCRIBED AND SWORN to before me this 8th day of July, 1953.

My commission expires January 4, 1954  
Marguerite Jettie  
Notary Public.

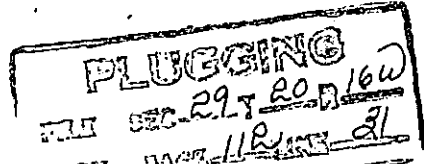

DRILLER'S LOG

Imperial Drilling Company, Inc.  
 903 Union National Bank Building  
 Wichita 2, Kansas

Fox #1  
 SW SE SE Sec. 29-20S-16W  
 Pawnee County, Kansas

Total Depth: 3837'

Elevation: 2031 R.B.

Commenced: 6-15-53 Completed: 7-4-53

Production: D & A

Contractor: Imperial Drilling Company, Inc.  
 903 Union National Bank Building  
 Wichita 2, Kansas

Casing Record: Set 315' of 8 5/8" surface pipe with 200 sacks cement.

Figures Indicate bottom of formations:

Surface Clay & Sand	100'		<u>TOPS</u>	
Shale & Shells	460'			
Sand	580'	Elevation:		2031 R.B.
Dakota Sand	630'	Anhydrite	1050'	(-981)
Red Bed & Shale	1050'	Heebner	3391'	(-1360)
Anhydrite	1075'	Lansing	3482'	(-1451)
Red Bed, Shale & Salt	1395'	Base K.C.	3702'	(-1671)
Shale & Salt	1580'	Arbuckle	3787'	(-1756)
Red Bed & Shale	1640'			
Shale & Lime	3492'	Total Depth	3837'	(-1806)
Lime	3837'			
Total Depth	3837'			

We hereby certify this to be a correct and accurate log of the above described well as shown on the daily drilling reports.

IMPERIAL DRILLING COMPANY, INC.

By: *Raymond L. Bacon*  
 Vice-President

Subscribed and sworn to before me this 7th day of July, 1953.

*Raymond L. Little*  
 Notary Public

My Commission Expires:

*January 4, 1954*

JUL 10 1953  
 CONSERVATION DEPARTMENT  
 Wichita, Kansas

**PLUGGING**  
 FILE SEC. 29 T. 20 R. 16W  
 BOOK PAGE 112 LINE 91