


STATE OF KANSAS
STATE CORPORATION COMMISSION

WELL PLUGGING RECORD

Give All Information Completely
Make Required Affidavit
Mail or Deliver Report to
Conservation Division
State Corporation Comm.
245 North Water
Wichita, KS 67202

Pawnee County, Sec. 28 Twp. 20 Rge. 16 N/W
Location as "NE/CNW 1/4 SW 1/4" or footage from lines
SW SW NE
Lease Owner The C. L. Morris Oil Corporation
Lease Name Eleske Well No. 1
Office Address 430 Lioba-Box 367-Andover, Kansas 67002
Character of Well (Completed as Oil, Gas or Dry Hole) Dry Hole
Date Well completed July 24 1980
Application for plugging filed July 24 1980
Application for plugging approved July 24 1980
Plugging commenced July 24 1980
Plugging completed July 24 1980
Reason for abandonment of well or producing formation Dry Hole
If a producing well is abandoned, date of last production N/A 19
Was permission obtained from the Conservation Division or its agents before plugging was commenced? Yes
Name of Conservation Agent who supervised plugging of this well William T. Owen
Producing formation Depth to top Bottom Total Depth of Well 3873
Show depth and thickness of all water, oil and gas formations.

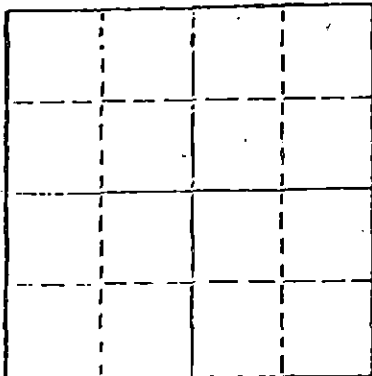

Locate well correctly on above Section Plot

OIL, GAS OR WATER RECORDS

CASING RECORD

FORMATION	CONTENT	FROM	TO	SIZE	PUT IN	PULLED OUT

Describe in detail the manner in which the well was plugged, indicating where the mud fluid was placed and the method or methods used in introducing it into the hold. If cement or other plugs were used, state the character of same and depth placed, from feet to feet for each plug set.

Plugged @ 700' with 50 sacks
Plugged @ 40' with 10 sacks
Plugged @ 10' with 5 sacks
Plugged with 50/50 Posmix - 4% Gel

JAN 20 1981

(If additional description is necessary, use BACK of this sheet)
Name of Plugging Contractor

STATE OF Kansas COUNTY OF Butler, ss.
J. V. Crawford, Vice President
of the above-described well, being first duly sworn on oath, says: That I have knowledge of the facts, statements, and matters herein contained and the log of the above-described well as filed and that the same are true and correct. So help me God.

(Signature) J. V. Crawford
J. V. Crawford, Ramco Drilling Corporation - Box 367 - 430 Lioba - Andover
Kansas 67002
(Address)

SUBSCRIBED AND SWORN TO before me this 19 day of January, 19 81

Sandra Kay May
Sandra Kay May Notary Public.

My commission expires

