

STATE OF KANSAS
STATE CORPORATION COMMISSION

WELL PLUGGING RECORD

OR
FORMATION PLUGGING RECORD

Strike out upper line when reporting plugging of formations.

Give All Information Completely
Make Required Affidavit
Mail or Deliver Report to:
Conservation Division
State Corporation Commission
800 Biltmore Building
Wichita, Kansas

Pawnee County. Sec. 28 Twp. 20 Rge. (E) 16 (W)

Location as "NE 1/4 NW 1/4 SW 1/4" or footage from lines SW 1/4 NW 1/4 NW 1/4

Lease Owner Iron Drilling Co.

Lease Name Fleske Well No.

Office Address 1206 Philtower Bldg., Tulsa, Okla.

Character of Well (completed as Oil, Gas or Dry Hole) Dry Hole

Date well completed April 17 19 51

Application for plugging filed " 19 51

Application for plugging approved " 19 51

Plugging commenced " 19 51


Plugging completed " 19 51

Reason for abandonment of well or producing formation

Dry Hole

If a producing well is abandoned, date of last production None 19

Was permission obtained from the Conservation Division or its agents before plugging was commenced? Yes

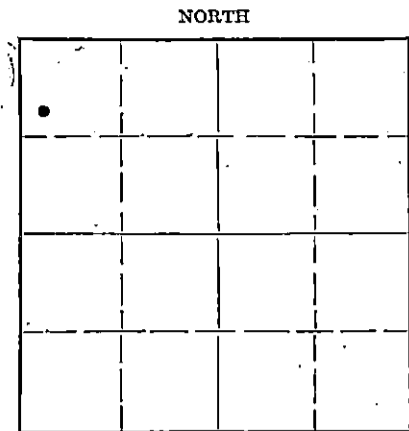

Locate well correctly on above Section Plat

Name of Conservation Agent who supervised plugging of this well C. D. Stough

Producing formation Depth to top Bottom Total Depth of Well Feet

Show depth and thickness of all water, oil and gas formations.

OIL, GAS OR WATER RECORDS

CASING RECORD

Formation	Content	From	To	Size	Put In	Pulled Out
Anhydrite	Dry	1098		8-5/8	808	None
Hebner	"	3446				
Lansing	"	3528				
Simpson	"	3893				
Arbuckle	"	3904				

Describe in detail the manner in which the well was plugged, indicating where the mud fluid was placed and the method or methods used in introducing it into the hole. If cement or other plugs were used, state the character of same and depth placed, from feet to feet for each plug set.

Hole filled with heavy Mud

15 sacks of Cement set as plug at 250 feet

10 " " " " " 35 feet

RECEIVED
STATE CORPORATION COMMISSION
MAY 12 1951
CONSERVATION DIVISION
Wichita, Kansas

(If additional description is necessary, use BACK of this sheet)

Correspondence regarding this well should be addressed to Iron Drilling Company
Address 1206 Philtower Bldg., Tulsa, Okla.

STATE OF Oklahoma, COUNTY OF Tulsa, ss.
J. L. Stackpole (employee of owner) or (owner or operator) of the above-described well,

being first duly sworn on oath, says: That I have knowledge of the facts, statements, and matters herein contained and the log of the above-described well as filed and that the same are true and correct. So help me God.

(Signature) J. L. Stackpole

1206 Philtower Bldg., Tulsa, Okla.
(Address)

SUBSCRIBED AND SWORN to before me this 24th day of April, 19 51

My commission expires

Feb. 28, 1952

PLUGGING
FILE SEC 28 T 20 R 16
BOOK PAGE 75 LINE 9

2-48-16M

Notary Public.

B. Michal

DRILLING RECORD

15 145 00153 0000

Well No. 1 A. W. Fleske
 Located SW/4 NW/4 NW/4 of
 Section 28-20S-16W
 Pawnee County, Kansas

Casing Record

600' of 8-5/8" OD Surface Pipe
 cemented with 400 sacks.

No Oil String - Dry Hole

Drilling Commenced 4/14/51
 Drilling Completed 4/17/51

WELL LOG

Surface Clay	0 to 40
Sand	40 to 70
Shale & Sand	70 to 100
River Sand	100 to 135
Shale & Shells	135 to 385
Blue Shale	385 to 410
Shale	410 to 485
Sand	485 to 655
Shale	655 to 680
Sand	685 to 700
Shale & Red Bed	700 to 805
Red Bed	805 to 1098
Anhydrite	1098 to 1133
Shale & Shells	1133 to 1550
Salt & Shale	1550 to 1600
Shale & Sand	1600 to 1845
Shale & Shells	1845 to 1940
Lime & Shale	1940 to 2430
Lime	2430 to 2490
Shale & Lime	2490 to 2575
Shale & Shells	2575 to 2590
Shale	2590 to 2630
Lime & Shale	2630 to 3529
K. C. Lime	3529 to 3555
Lime	3555 to 3585
Lime & Chert	3585 to 3640
Lime	3640 to 3820
Cherty Lime	3820 to 3839
Chert	3839 to 3882
S. Shale	3882 to 3885
Chert & Conglomerate	3885 to 3908
Dolomite	3908 to 3943 TD

RECEIVED
 STATE CORPORATION COMMISSION
 MAY 22 1951
 CONSERVATION DIVISION
 Wichita, Kansas

PLUGGING
 REC-21-T-20-R(60)
 PAGE 25 LINE 9