

STATE OF KANSAS
STATE CORPORATION COMMISSION


Form CP-4

WELL PLUGGING RECORD

Give All Information Completely.
Make Required Affidavit
Mail or Deliver Report to:
Conservation Division
State Corporation Commission
211 No. Broadway
Wichita, Kansas

Pawnee County, Sec. 22 Twp. 20S Rge. (E) 16 (W)

Location as "NE/CNW/SW" or footage from lines NE SW SW
Lease Owner John C. Graves, et al
Lease Name Smith Well No. 1
Office Address 412 Union Center, Wichita, Kansas
Character of Well (completed as Oil, Gas or Dry Hole) Dry Hole
Date well completed September 2, 19 65
Application for plugging filed September 2, 19 65
Application for plugging approved September 2, 19 65
Plugging commenced September 2, 19 65
Plugging completed September 2, 19 65
Reason for abandonment of well or producing formation

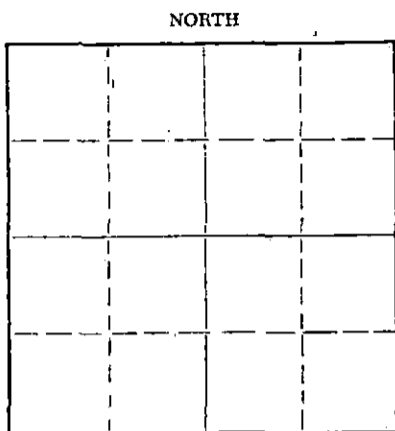

Locate well correctly on above Section Plat

If a producing well is abandoned, date of last production 19
Was permission obtained from the Conservation Division or its agents before plugging was commenced? Yes

Name of Conservation Agent who supervised plugging of this well Eldon Petty, Hays, Kansas
Producing formation Depth to top Bottom Total Depth of Well 3828 Feet
Show depth and thickness of all water, oil and gas formations.

OIL, GAS OR WATER RECORDS

CASING RECORD

FORMATION	CONTENT	FROM	TO	SIZE	PUT IN	PULLED OUT

Describe in detail the manner in which the well was plugged, indicating where the mud fluid was placed and the method or methods used in introducing it into the hole. If cement or other plugs were used, state the character of same and depth placed, from feet to feet for each plug set.

Mudded up with heavy mud to 450 feet. Followed by wooden plug, 1/4 sack hulls and 20 sacks cement onto hulls. Mudded up with heavy mud to 240 feet followed by wooden plug, 1/4 sack hulls and 20 sacks cement onto hulls. Mudded up with heavy mud to 40 feet followed by wooden plug, 1/4 sack hulls and 10 sacks cement to base of well cellar. Plugged rat hole with 2 sacks cement.

RECEIVED
STATE CORPORATION COMMISSION

SEP 16 1965

CONSERVATION DIVISION
Wichita, Kansas

(If additional description is necessary, use BACK of this sheet)
Name of Plugging Contractor GRAVES DRILLING CO., INC.
Address 412 Union Center, Wichita, Kansas

STATE OF KANSAS, COUNTY OF BUTLER, ss.
John C. Graves (employee of owner) or (owner or operator) of the above-described well, being first duly sworn on oath, says: That I have knowledge of the facts, statements, and matters herein contained and the log of the above-described well as filed and that the same are true and correct. So help me God.

(Signature) *John C. Graves*
412 Union Center, Wichita, Kansas
(Address)

SUBSCRIBED AND SWORN to before me this 15th day of September, 19 65

My commission expires April 30, 1967 Betty Brandt Notary Public.

ROTARY DRILLERS' LOG

OPERATOR: John C. Graves, et al DRILLING COMMENCED: August 27, 1965
 412 Union Center
 Wichita, Kansas

CONTRACTOR: Graves Drilling Co., Inc. DRILLING COMPLETED: September 2, 1965
 412 Union Center
 Wichita, Kansas

CASING RECORD: 25 Jts. 1070' 8-5/8" LOCATION: Smith No. 1
 cemented with 400 sacks NE SW SW
 Section 22-20S-16W
 Pawnee County, Kansas


0 - 100 Soil and red shale
 100 - 455 Shale & shells
 455 - 610 Sand
 610 - 928 Shale & red bed
 928 - 1064 Shale
 1064 - 1088 Lime
 1088 - 1519 Shale & shells
 1519 - 1980 Shale & lime
 1980 - 3514 Lime & shale
 3514 - 3670 Lime
 3670 - 3791 Lime & shale
 3791 - 3828 Lime
 3828 Rotary Total Depth

RECEIVED
 STATE CORPORATION COMMISSION
 SEP 16 1965
 CONSERVATION DIVISION
 Wichita, Kansas

I hereby certify the foregoing statements to be true and correct to the best of my knowledge.

GRAVES DRILLING CO., INC.

By *John C. Graves*
President

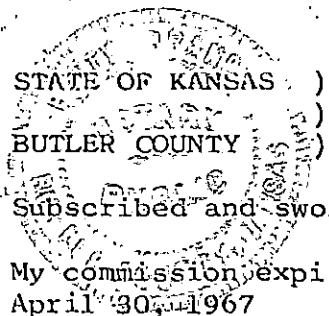

SS:

Subscribed and sworn to before me, a Notary Public, this 15th day of September, 1965.

My commission expires:
April 30, 1967

Betty Brandt
Betty Brandt Notary Public