


Give All Information Completely
Make Required Affidavit
Mail or Deliver Report to:
Conservation Division
State Corporation Commission
311 No. Broadway
Wichita, Kansas

WELL PLUGGING RECORD

NORTH

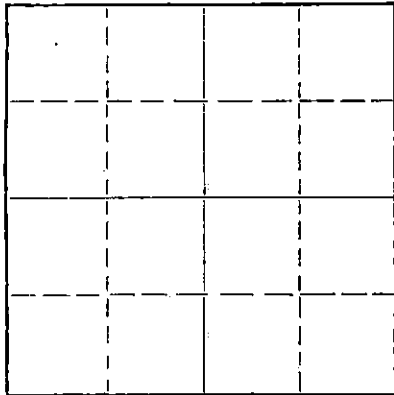

Locate well correctly on above
Section Plat

Pawnee County, Sec. 22 Twp. 20 Rge. 16 (E) (W)
Location as "NE/CNW/SW" or footage from lines SW SE NW
Lease Owner Sierra Petroleum Co., Inc.
Lease Name SMITH Well No. 1
Office Address 420 W. Douglas Ave., Wichita, Kansas
Character of Well (completed as Oil, Gas or Dry Hole) Dry
Date well completed 12/4/56 19
Application for plugging filed 12/3/56 19
Application for plugging approved 12/3/56 19
Plugging commenced 12/4/56 19
Plugging completed 12/4/56 19
Reason for abandonment of well or producing formation Dry

If a producing well is abandoned, date of last production _____ 19
Was permission obtained from the Conservation Division or its agents before plugging was commenced? yes

Name of Conservation Agent who supervised plugging of this well Mr. Brundage
Producing formation _____ Depth to top _____ Bottom _____ Total Depth of Well 3880 Feet
Show depth and thickness of all water, oil and gas formations.

OIL, GAS OR WATER RECORDS

CASING RECORD

FORMATION	CONTENT	FROM	TO	SIZE	PUT IN	PULLED OUT
				8 5/8	258	none

Describe in detail the manner in which the well was plugged, indicating where the mud fluid was placed and the method or methods used in introducing it into the hole. If cement or other plugs were used, state the character of same and depth placed, from _____ feet to _____ feet for each plug set.

PLUGGING RECORD

Filled with heavy mud from 3880 up to 320. Put in rock bridge, 50 sacks cement through drill pipe up to 230'. Filled with heavy mud from 230' up to 35'. Set wood plug with 1/3 sacks hulls and 10 sacks cement to cellar 0.

RECEIVED
STATE CORPORATION COMMISSION
DEC 5 - 1956
CONSERVATION DIVISION
Wichita, Kansas

(If additional description is necessary, use BACK of this sheet)
Name of Plugging Contractor Sierra Petroleum Co., Inc.
Address 420 W. Douglas Ave., Wichita, Kansas

STATE OF KANSAS, COUNTY OF RUSSELL, ss.
C. T. Honaker (employee of owner) or (owner or operator) of the above-described well, being first duly sworn on oath, says: That I have knowledge of the facts, statements, and matters herein contained and the log of the above-described well as filed and that the same are true and correct. So help me God.

(Signature) C. T. Honaker

SUBSCRIBED AND SWORN TO before me this 5th day of December, 19 56

(Address) Margie Cooper
Notary Public.

My commission expires 1-30-57.

PLUGGING
FILE SEC 22 T. 20 R. 16 E
BOOK PAGE 122 LINE 42

15.145.00149.0000

Sierra Petroleum Co., Inc.

SMITH #1

SW SE NW Sec. 22-20-16
Pawnee County, Kansas

Total Depth: 3880'

Elev: 2071 KB

Comm: 11/23/56

Comp: 12/4/56

8 5/8" @ 258'

with 150 sacks cement

FORMATION	DEPTH
Clay, sand & shale	258
Shale	310
Shale & Sand	480
Sand, shale & redbed	1095
Anhydrite	1125
Shale & shells	1310
Shale & lime	1580
Salt & shale	1680
Shale & Lime	1950
Lime	2010
Lime & shale	2050
Lime	2330
Lime & shale	2945
Lime	3060
Lime & shale	3272
Lime	3368
Lime & shale	3525
Lime	3820
Arbuckle	3880

Tops:		
Heebner		3420-1348
Toronto		3433-1361
Douglas Shale		3448-1378
Brown Lime		3501-1429
Lansing K. C.		3510-1438
Arbuckle		3820

STATE OF KANSAS)
)
 COUNTY OF RUSSELL) ss:

I hereby certify that the above information is true and correct to the best of my knowledge.

C. P. Hawker

Subscribed and sworn to before me this 5th day of December, 1956.

Margie Cooper

Notary Public
 RECEIVED
 STATE CORPORATION COMMISSION
 DEC 5 - 1956
 CONSERVATION DIVISION
 Topeka, Kansas

My commission expires: 1-30-57.

PLUGGING
 T1L - SEC 22 T 20 R 16E
 BOOK PAGE 122 LINE 42