


STATE OF KANSAS
STATE CORPORATION COMMISSION

Form CP-4

Give All Information Completely
Make Required Affidavit
Mail or Deliver Report to:
Conservation Division
State Corporation Commission
P. O. Box 17027
Wichita, Kansas 67217
NORTH

WELL PLUGGING RECORD

Barton County. Sec. 3 Twp. 20 Rge. 15 (E) W (W)
Location as "NE/CNWSW" or footage from lines NE/4 NW/4 SW/4
Lease Owner Icer Addis
Lease Name UNRUH Well No. 1
Office Address 5307 E. Central - Wichita, Kansas 67208
Character of Well (completed as Oil, Gas or Dry Hole) Dry Hole
Date well completed September 9 19 73
Application for plugging filed Sept. 9 19 73
Application for plugging approved Sept. 9 19 73
Plugging commenced Sept. 9 19 73
Plugging completed Sept. 9 19 73
Reason for abandonment of well or producing formation _____

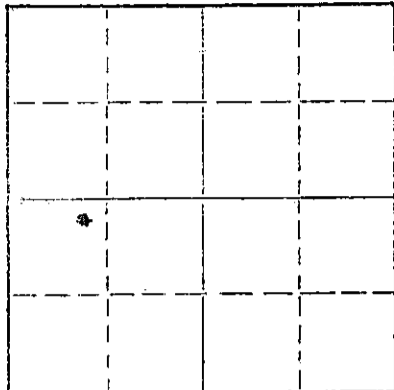

Locate well correctly on above
Section Flat

If a producing well is abandoned, date of last production _____ 19 ____
Was permission obtained from the Conservation Division or its agents before plugging was commenced? yes

Name of Conservation Agent who supervised plugging of this well Donald Truan
Producing formation _____ Depth to top _____ Bottom _____ Total Depth of Well 3713 Feet
Show depth and thickness of all water, oil and gas formations.

OIL, GAS OR WATER RECORDS

CASING RECORD

FORMATION	CONTENT	FROM	TO	SIZE	PUT IN	PULLED OUT

Describe in detail the manner in which the well was plugged, indicating where the mud fluid was placed and the method or methods used in introducing it into the hole. If cement or other plugs were used, state the character of same and depth placed, from _____ feet to _____ feet for each plug set.

Hole full of heavy mud.
Bottom plug set at 300' w/25 sacks cement thru drill pipe.
Come up hole to 40' = set plug, with 1/2 sack hulls and 10 sacks cement.
2 sacks cement in rat hole.

RECEIVED
STATE CORPORATION COMMISSION

SEP 11 1973

CONSERVATION DIVISION
Wichita, Kansas

(If additional description is necessary, use BACK of this sheet)

Name of Plugging Contractor _____
Address _____

STATE OF Kansas COUNTY OF Barton, ss.
Leonard Williamson (employee of owner) or (~~owner~~) of the above-described

well, being first duly sworn on oath, says: That I have knowledge of the facts, statements, and matters herein contained and the log of the above-described well as filed and that the same are true and correct. So help me God.

(Signature) Leonard Williamson
1105 Williams, Great Bend, Ks. 67530
(Address)

SUBSCRIBED AND SWORN to before me this 10 day of Sept., 19 73.

My commission expires April 11, 1974

Shirley M. Flague
Notary Public.

WELL LOG

DATE COMMENCED: August 30, 1973
DATE COMPLETED: September 9, 1973

Icer Addis
UNRUH #1
NE NW SW
Sec. 3-T20S-R15s
Barton County, Kansas

ELEVATION: 1980 K.B.

0	-	40'	Clay & Post Rock
40	-	365'	Shale & Sand Streaks
365	-	605'	Sand & Shale
605	-	953'	Red Bed
953	-	981'	Anhydrite
981	-	1086'	Red Bed
1086	-	1470'	Shale & Shells
1470	-	2933'	Lime & Shale
2933	-	3267'	Lime
3267	-	3282'	Shale & Lime
3282	-	3295'	Lime
3295	-	3348'	Shale
3348	-	3357'	Lime & Shale
3357	-	3581'	Lime
3581	-	3713'	Lime, Shale & Chert
3713			RTD

FORMATION DATA

Anhydrite	953
Topeka	2933
Heebner	3267
Toronto	3282
Douglas	3295
Br. Lime	3348
Kansas City	3357
Base K.C.	3581
Conglomerate	3622
RTD	3713

RECEIVED
STATE CORPORATION COMMISSION

SEP 11 1973

CONSERVATION DIVISION
Wichita, Kansas

SURFACE PIPE: Set used
8-5/8", 28# surface pipe
at 963' with 400 sacks
cement.

AFFIDAVIT

STATE OF KANSAS
COUNTY OF BARTON) ss.

Leonard Williamson, of lawful age, does hereby swear and state
that the facts and statements herein contained are true and correct
to the best of his knowledge.

Leonard Williamson

Subscribed and sworn to before me this 10th day of September 1973.

My Comm. Expires:
April 11, 1974

Clairthy M. Hague
Notary Public