


WELL PLUGGING RECORD

Give All Information Completely
Make Required Affidavit
Mail or Deliver Report to:
Conservation Division,
State Corporation Commission
800 Bittling Building
Wichita, Kansas

NORTH

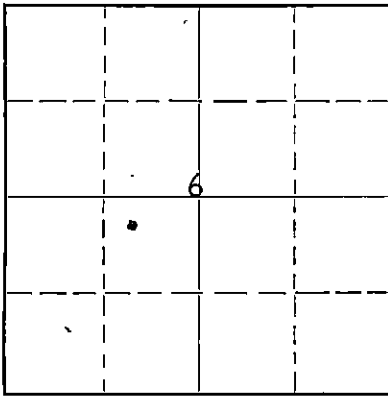

Locate well correctly on above
Section Plat

Barton County, Sec. 6 Twp. 20S Rge. 15W (E) W (W)
Location as "NE/CNW $\frac{1}{4}$ SW $\frac{1}{4}$ " or footage from lines NW $\frac{1}{4}$, NE $\frac{1}{4}$, SW $\frac{1}{4}$,
Lease Owner Amerada Petroleum Corporation
Lease Name Smith Estate Well No. 1
Office Address P. O. Box #197, Great Bend, Kansas
Character of Well (completed as Oil, Gas or Dry Hole) Oil
Date well completed 6/13/47 19
Application for plugging filed 7/27/54 19
Application for plugging approved 7/27/54 19
Plugging commenced 8/5/54 19
Plugging completed 8/9/54 19
Reason for abandonment of well or producing formation Unprofitable to Operate
If a producing well is abandoned, date of last production 6/30/54 19
Was permission obtained from the Conservation Division or its agents before plugging was commenced? Yes

Name of Conservation Agent who supervised plugging of this well Warren Horner
Producing formation Depth to top Bottom Total Depth of Well 3765 Feet
Show depth and thickness of all water, oil and gas formations.

OIL, GAS OR WATER RECORDS

CASING RECORD

Formation	Content	From	To	Size	Put In	Pulled Out
				8-5/8"	1023'	None
				5-1/2"	3764'	2783'

Describe in detail the manner in which the well was plugged, indicating where the mud fluid was placed and the method or methods used in introducing it into the hole. If cement or other plugs were used, state the character of same and depth placed, from feet to feet for each plug set.

Filled hole w/Sand from 3765' to 3715', & Dumped 5 Sacks cement on top of sand, filled hole to 300' from top, set rock bridge, dumped 20 sacks cement on bridge, filled hole to with in 35' of top, set rock bridge, dumped 10 Sacks cement on top of bridge filling hole to top of surface casing in bottom of cellar.

(If additional description is necessary, use BACK of this sheet)

Correspondence regarding this well should be addressed to Amerada Petroleum Corporation
Address P. O. Box #197, Great Bend, Kansas

STATE OF Kansas, COUNTY OF Barton, ss.
R. A. Drake (employee of owner) or (owner or operator) of the above-described well,
being first duly sworn on oath, says: That I have knowledge of the facts, statements, and matters herein contained and the log of the above-described well as filed and that the same are true and correct. So help me God.

(Signature) R. A. Drake

Box #197, Great Bend, Kansas
(Address)

SUBSCRIBED AND SWORN TO before me this 13th day of August, 1954

My commission expires 2-11-55

22-7877-8 4-49-10M

PLUGGING
FILE SEC 6 T 20 R 15W
BOOK PAGE 52 LINE 4

Notary Public.
STATE CORPORATION COMMISSION

AUG 14 1954

CONSERVATION DIVISION
Wichita, Kansas

8-14-1954


WELL LOG

Smith Estate #1 - Sec. 6 - 20S, 15W,
Barton County, Kansas.

Soil & Clay	-	40'
Shale	-	95'
Shale w/Sand Streaks	-	375'
Shale	-	388'
Sand	-	555'
Shale	-	592'
Sand & Shale Streaks	-	722'
Red Bed w/Sand Streaks	-	818'
Sand	-	847'
Red Bed	-	1015'
Anhydrite	-	1038'
Shale & Shells	-	1452'
Salt & Shale	-	1698'
Shale & Shells	-	1793'
Anhydrite & Shale Strks.	-	1870'
Anhydrite	-	1894'
Anhydrite & Shale Strks.	-	1986'
Shale	-	2011'
Bro. Lime & Shale	-	2042'
Bro. Lime	-	2140'
Lime	-	2180'
Shale & Lime	-	2205'
Bro. Lime & Shale	-	2368'
Shale & Lime	-	2463'
Lime	-	2488'
Shale	-	2554'
Lime	-	2565'
Shale & Lime	-	2628'
Shale & Lime Streaks	-	2736'
Shale	-	2782'
Bro. Lime & Shale	-	2862'
Bro. Lime w/Shale Strks.	-	2934'
Shale	-	2980'
Shale & lime	-	3004'
Bro. Lime & Shale	-	3092'
Lime & Shale	-	3150'
Lime	-	3374'
Lime & Shale	-	3397'
Lime	-	3420'
Lime	-	3676'
Conglomerate	-	3682'
Dolomite	-	3687'
Arbuckle Lime	-	3765'
T.D.	-	3765'

Amerada Petroleum Corp.

By *C. E. Richardson*

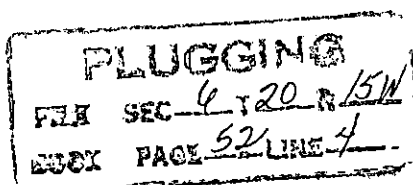

RECEIVED
THE CORPORATION COMMISSION
OFFICE OF THE
CONSERVATION DIVISION
