


WELL PLUGGING RECORD

Give All Information Completely
Make Required Affidavit
Mail or Deliver Report to:
Conservation Division
State Corporation Commission
800 Bitts Bldg
Wichita, Kansas

NORTH

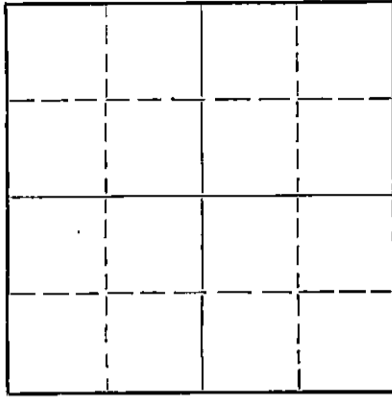

Locate well correctly on above
Section Plat

Barton County, Sec. 6 Twp. 20S Rge. 15W (E) (W)
Location as "NE/CNW/SW" or footage from lines SE SW NW
Lease Owner Lawrence Supply Company
Lease Name Dirks "A" Well No. 1
Office Address Box 448 - Great Bend, Kansas
Character of Well (completed as Oil, Gas or Dry Hole) _____
Date well completed _____ 19 _____
Application for plugging filed April 14 19 54
Application for plugging approved April 16 19 54
Plugging commenced April 14 19 54
Plugging completed April 24 19 54
Reason for abandonment of well or producing formation _____

If a producing well is abandoned, date of last production _____ 19 _____
Was permission obtained from the Conservation Division or its agents before plugging was commenced? Yes

Name of Conservation Agent who supervised plugging of this well Warren H. Horner
Producing formation _____ Depth to top _____ Bottom _____ Total Depth of Well 3753 Feet
Show depth and thickness of all water, oil and gas formations.

OIL, GAS OR WATER RECORDS

CASING RECORD

FORMATION	CONTENT	FROM	TO	SIZE	PUT IN	PULLED OUT
				8-5/8"		
				5-1/2"		2035'

Describe in detail the manner in which the well was plugged, indicating where the mud fluid was placed and the method or methods used in introducing it into the hole. If cement or other plugs were used, state the character of same and depth placed, from _____ feet to _____ feet for each plug set.

Filled hole with rock from 3753' to 3700' and ran 5 sacks of cement on rock. Mudded hole to 310', set a 10' rock bridge and ran 20 sacks of cement at 300'. Mudded hole to 35' and ran 10 sacks of cement on top. Plugging completed.

(If additional description is necessary, use BACK of this sheet)
Name of Plugging Contractor West Supply Company
Address Chase, Kansas

STATE OF Kansas, COUNTY OF Barton, ss.
P. B. Lawrence (employee of owner) or (owner or operator) of the above-described well, being first duly sworn on oath, says: That I have knowledge of the facts, statements, and matters herein contained and the log of the above-described well as filed and that the same are true and correct. So help me God. Lawrence Supply Co.
(Signature) P. B. Lawrence

SUBSCRIBED AND SWORN to before me this 15th day of June, 1954
Walter O. Volk
(Address) Great Bend, Kansas

My commission expires Sept. 15, 1956 Notary Public.

PLUGGING
FILE SEC 6 T 20 R 15W
BOOK PAGE 27 LINE 39

24-7366-6 3-53-20M

RECEIVED
STATE CORPORATION COMMISSION
JUN 16 1954
CONSERVATION DIVISION
Wichita, Kansas

6-16-1954


WELL LOG BUREAU - KANSAS GEOLOGICAL SOCIETY
412 Union National Bk. Bldg., Wichita, Kansas

Company - THE PHIL-HAN OIL COMPANY
Farm - Dirks "A" No. 1

SEC. 6 T. 20 R. 15W
SE SW NW

Total Depth. 3753'
Comm. 8-8-47 Comp. 9-13-47
Shot or Treated.
Contractor.
Issued. 11-8-47

County. Barton
KANSAS

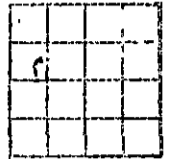

CASING:
8-5/8" 1014' Cem. W/425 Sx.
5-1/2" 3720' Cem. W/150 Sx.

Elevation. _____

Production. Est. 15 LQ 30% wtr.

Figures Indicate Bottom of Formations.

sand, shale & shells	385
shale	400
sand	520
shale	785
shale & red rock	990
red rock	1009
anhydrite	1035
shale & shells	1485
salt, shale & shells	1775
shale & lime	1800
lime	2200
lime & shale	2285
lime	2375
lime & shale	2450
lime	2500
shale & lime	2630
shale	2675
lime & shale	2840
lime	3435
lime & chert	3510
lime	3665
lime (Arbuckle)	3705
lime & chert	3722
lime & chert	3753
Total Depth	3753

TOPS:

Heebner	3293
Lansing	3376
Arbuckle	3654
T.D.	3753

3720-22 500 gal. acid &
1,000 gal. acid. Drilled
deeper 3722 to 3753 T.D.
Show oil 3747-53 - 500 gal.
acid & 1,500 acid. Est.
15 BOPH 30% Wtr.

PLUGGING
FILE SEC 6 T. 20 R. 15W
BOOK PAGE 27 LINE 37

RECEIVED
STATE COMPLETION COMMISSION
JUN 16 1954
CONSERVATION DIVISION
Wichita, Kansas