


STATE OF KANSAS
STATE CORPORATION COMMISSION

Give All Information Completely
Make Required Affidavit
Mail or Deliver Report to:
Conservation Division
State Corporation Commission
211 No. Broadway
Wichita, Kansas

WELL PLUGGING RECORD

NORTH

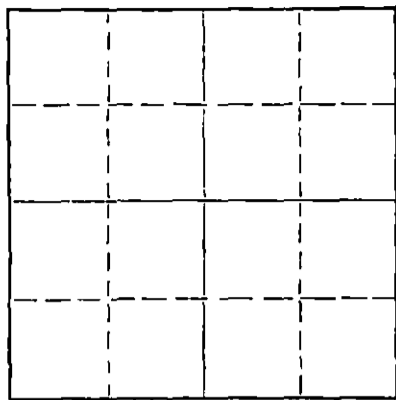

Locate well correctly on above
Section Plot

Barton County. Sec. 8 Twp. 20S Rge. 15W (E) (W)

Location as "NE/CNW/SW" or footage from lines NE SW NW

Lease Owner Alkay Royalties, Inc.

Lease Name Deckert Well No. 1

Office Address 302 Bettis Bldg., 1501 Classen Blvd., Okla City,

Character of Well (completed as Oil, Gas or Dry Hole) Dry Hole Okla.

Date well completed 8-12-64 19

Application for plugging filed 8-12-64 19

Application for plugging approved 8-12-64 19

Plugging commenced 8-12-64 19

Plugging completed 8-12-64 19

Reason for abandonment of well or producing formation Dry Hole

If a producing well is abandoned, date of last production _____ 19

Was permission obtained from the Conservation Division or its agents before plugging was commenced? yes

Name of Conservation Agent who supervised plugging of this well Gilbert Leiker, Victoria, Kansas

Producing formation _____ Depth to top _____ Bottom _____ Total Depth of Well 3942' Feet

Show depth and thickness of all water, oil and gas formations.

OIL, GAS OR WATER RECORDS

CASING RECORD

FORMATION	CONTENT	FROM	TO	SIZE	PUT IN	PULLED OUT
				8 5/8"	1049'	none

Describe in detail the manner in which the well was plugged, indicating where the mud fluid was placed and the method or methods used in introducing it into the hole. If cement or other plugs were used, state the character of same and depth placed, from _____ feet to _____ feet for each plug set.

Mud to 240' Plug 20 sacks cement
Mud to 40' Plug 1/2 sack hulls 10 sacks cement
2 sacks in rathole.

RECEIVED
STATE CORPORATION COMMISSION

AUG 25 1964

CONSERVATION DIVISION
Wichita, Kansas

(If additional description is necessary, use BACK of this sheet)

Name of Plugging Contractor Leben Drilling, Inc.

Address Box 486, Great Bend, Kansas

STATE OF KANSAS, COUNTY OF BARTON, ss.
Leslie Kite

(employee of owner) or (owner or operator) of the above-described well, being first duly sworn on oath, says: That I have knowledge of the facts, statements, and matters herein contained and the log of the above-described well as filed and that the same are true and correct. So help me God.

(Signature) Leslie Kite

P. O. Box 486, Great Bend, Kansas
(Address)

SUBSCRIBED AND SWORN to before me this 18th day of August, 19 64

My commission expires April 1, 1967

Ulanda Nichols
Notary Public.

DRILLER'S LOG

COMPANY: Alkay Royalties, Inc.
 CONTRACTOR: LEBEN DRILLING, INC.
 FARM: DECKERT #1
 LOCATION: NE SW NW Sec. 8-20S-15W
 BARTON COUNTY, KANSAS
 COMMENCED: 8-1-64
 COMPLETED: 8-12-64

0	90	Surface Soil & Clay
90	130	Shale & Sand Streaks
130	460	Shale
460	575	Sand
575	630	Shale & Sand
630	739	Redbed
739	1039	Redbed & Shale
1039	1074	Anhydrite
1074	1740	Shale & Shells
1740	2339	Lime & Shale
2339	2545	Shale & Lime
2545	3086	Lime & Shale
3086	3942	Lime
	<u>3942</u>	<u>Rotary Total Depth - D. & A.</u>

Set 8 5/8" new surface casing @ 1049' cemented with 225 sacks
 Common with 2% Gel and 2% c.c. and 225 sacks Sunset with 2%
 Gel.

I, Leslie Kite, do hereby certify that the above and foregoing is
 a true and correct copy of the log of the Deckert #1 well, located
 NE SW NW of Section 8, Township 20 South, Range 15 West, Barton
 County, Kansas, this as reflected by the files of Leben Drilling,
 Inc.

Leslie Kite

 Leslie Kite

STATE OF KANSAS)
) SS
 COUNTY OF BARTON)

Subscribed and sworn to before me, a Notary Public, in and
 for Barton County, Kansas, this 18th day of August, 1964.

Ulanda Nichols

 Ulanda Nichols

My Commission Expires
 April 1, 1967

RECEIVED
 STATE CORPORATION COMMISSION

AUG 25 1964

CONSERVATION DIVISION
 Wichita, Kansas