


WELL PLUGGING RECORD

Give All Information Completely  
Make Required Affidavit  
Mail or Deliver Report to:  
Conservation Division  
State Corporation Commission  
211 No. Broadway  
Wichita, Kansas

Barton County, Sec. 8 Twp. 20 Rge. 15 (E) W (W)  
Location as "NE/CNW/SW" or footage from lines SW SW NW  
Lease Owner G.D. Davis Oil Account  
Lease Name S. Deckart "D" Well No. 1  
Office Address Hays, Kansas  
Character of Well (completed as Oil, Gas or Dry Hole) \_\_\_\_\_  
Date well completed \_\_\_\_\_ 19\_\_\_\_  
Application for plugging filed \_\_\_\_\_ 19\_\_\_\_  
Application for plugging approved \_\_\_\_\_ 19\_\_\_\_  
Plugging commenced 12-14-64 \_\_\_\_\_ 19\_\_\_\_  
Plugging completed 12-18-64 \_\_\_\_\_ 19\_\_\_\_  
Reason for abandonment of well or producing formation Depleted.

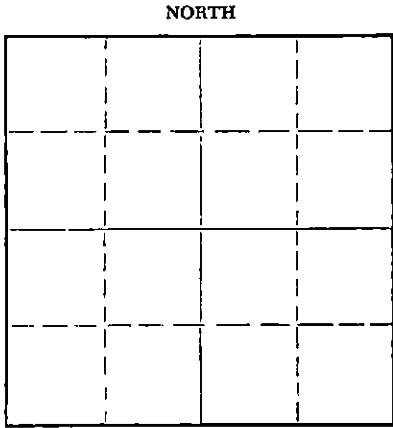

Locate well correctly on above  
Section Plat

If a producing well is abandoned, date of last production \_\_\_\_\_ 19\_\_\_\_  
Was permission obtained from the Conservation Division or its agents before plugging was commenced? yes

Name of Conservation Agent who supervised plugging of this well Don Truan  
Producing formation \_\_\_\_\_ Depth to top \_\_\_\_\_ Bottom \_\_\_\_\_ Total Depth of Well 3790 Feet  
Show depth and thickness of all water, oil and gas formations.

OIL, GAS OR WATER RECORDS

CASING RECORD

FORMATION	CONTENT	FROM	TO	SIZE	PUT IN	PULLED OUT
				8-5/8"	1060'	None
				5-1/2"	3790'	2787'

Describe in detail the manner in which the well was plugged, indicating where the mud fluid was placed and the method or methods used in introducing it into the hole. If cement or other plugs were used, state the character of same and depth placed, from \_\_\_\_\_ feet to \_\_\_\_\_ feet for each plug set.

Checked hole to 3719', plug back, sanded to 3685'  
and dumped 5 sacks of cement @ 3685' with dump  
bailer. Pulled 5 1/2" casing, bridged hole @ 400'  
and dumped 25 sacks of cement. Mudded hole to 40'  
and ran 10 sacks of cement to base of cellar.

RECEIVED  
STATE CORPORATION COMMISSION

PLUGGING COMPLETE.

JAN 14 1965

1-14-1965  
CONSERVATION DIVISION  
Wichita, Kansas

(If additional description is necessary, use BACK of this sheet)

Name of Plugging Contractor KNIGHT CASING PULLING COMPANY  
Address CHASE, KANSAS

STATE OF KANSAS, COUNTY OF RICE, ss.  
Noel J. Knight (employee of owner) or (~~owner or operator~~) of the above-described well, being first duly sworn on oath, says: That I have knowledge of the facts, statements, and matters herein contained and the log of the above-described well as filed and that the same are true and correct. So help me God.

(Signature) Noel J. Knight  
Chase, Kansas  
(Address)

SUBSCRIBED AND SWORN TO before me this 5th day of January, 1965

My commission expires May 20, 1968  
Milton J. Volin Notary Public.