

STATE OF KANSAS
STATE CORPORATION COMMISSION

WELL PLUGGING RECORD


Give All Information Completely
Make Required Affidavit
Mail or Deliver Report to:
Conservation Division
State Corporation Commission
800 Bitting Building
Wichita, Kansas

OR

Strike out upper line
when reporting plug-
ging off formations.

~~WELL PLUGGING RECORD~~

NORTH

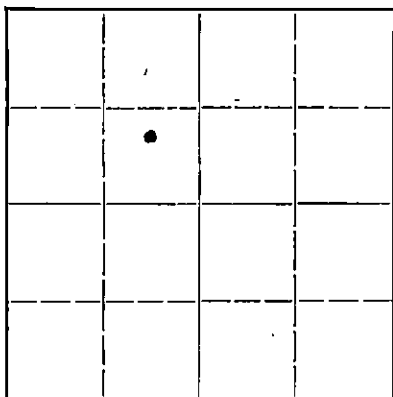

Locate well correctly on above
Section Plat

Barton County. Sec. 7 Twp. 20S Rge. (E) 15 (W)
Location as "NE $\frac{1}{4}$ NW $\frac{1}{4}$ SW $\frac{1}{4}$ " or footage from lines NW $\frac{1}{4}$, 330' fm Nth 660' fm East lin
Lease Owner. Sinclair Prairie Oil Co
Lease Name. J. P. Dirks Well No. 1
Office Address. ~~XXXXXX~~ Box 521, Tulsa, Okla.
Character of Well (completed as Oil, Gas or Dry Hole). Oil well
Date well completed. July 11, 1944 19
Application for plugging filed. June 21, 1948 19
Application for plugging approved. Verbally June 12, 1948 19
Plugging commenced. June 12 19 48
Plugging completed. June 18 19 48
Reason for abandonment of well or producing formation. Production depleted

If a producing well is abandoned, date of last production. May 19 48
Was permission obtained from the Conservation Division or its agents before plugging was com-
menced? yes - verbal.

Name of Conservation Agent who supervised plugging of this well. G.D. Stough.
Producing formation. Arbuckle Depth to top. 3687 Bottom. Total Depth of Well. 3766 Feet
Show depth and thickness of all water, oil and gas formations.


OIL, GAS OR WATER RECORDS

CASING RECORD

Formation	Content	From	To	Size	Put In	Pulled Out
Arbuckle	dry	3687	3766	9"OD	900	0
				5 $\frac{1}{2}$ "OD	3819	2928'

Describe in detail the manner in which the well was plugged, indicating where the mud fluid was placed and the method or methods used in introducing it into the hold. If cement or other plugs were used, state the character of same and depth placed, from.....feet to.....feet for each plug set.

Mud 3766-3750'
5 sx cmt 3750-3710'
Mud 3710- 900'
Rock Bridge 900-897'
15 sx cmt 897-822'
mud 822-200'
10 sx cmt 200-160'
Mud 160-150 15'
10 sx cmt 15-0

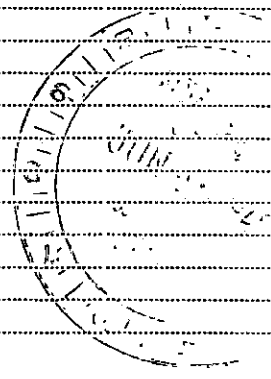

(If additional description is necessary, use BACK of this sheet)

Correspondence regarding this well should be addressed to Mr. E.H. Gibbons
Address. Box 774, Great Bend, Kas. 6-23-1948

STATE OF Kansas, COUNTY OF Barton, ss.
I, E.H. Gibbons (employee of owner) or (owner) of the above-described well,
being first duly sworn on oath, says: That I have knowledge of the facts, statements, and matters herein contained and the log of the above-described well as filed and that the same are true and correct. So help me God.


(Signature) *E.H. Gibbons*

Box 774 Great Bend, Kas.
(Address)

SUBSCRIBED AND SWORN to before me this 22nd day of June 1948

My commission expires 9/22/51

Notary Public.

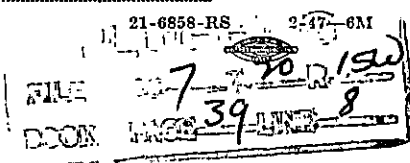

Sinclair Prairie Oil Co
Well Log

15.009.16598.0000

J. P. Dirks # 1

Sec. 7-20S-15W
Barton Co., Mo.
NW/4, 330' fm Nth 660' fm East lines.
Elev. 2024.

Drilling Begun June 21, 1944.
Completed July 11, 1944.
Drilled to 3795' P.B. to 3766'
Original potential 191 oil, 125 wtr.

Surface Sand & Clay	140'
Sand-Shale-Shells	435
Sand-Shale	877
Anhydrite	880
Lime	925
Set 920D csg at 890'w/200 sx.	
Red Bed & Sand	1310
Sand & Shale	1800
Lime	1950
Shale & Lime	2150
Lime	2265
Lime & Shale	2325
Lime	2615
Lime & Shale	2785
Shale & Lime	2810
Lime-broken	2935
Shale & Lime	2995
Lime-broken	3085
Lime & Shale	3160
Lime	3185
Lime-broken	3260
Lime	3440
Lime-chert	3515
Lime	3547
Lime-soft	3556
Lime	3600
Lime-chert	3620
Lime	3665
Lime-chert	3710
Lime	3795
P.B. w/Lane Wells plug & rock to 3766'	
Set 5 $\frac{1}{2}$ "OD csg at 3795'	
Top Arbuckle	3687'
Cmt plug drilled to 3791'	
Lane Wells plug	3772-3775'
Rock to 3766'	

