

STATE CORPORATION COMMISSION OF KANSAS  
OIL & GAS CONSERVATION DIVISION

WELL COMPLETION OR RECOMPLETION FORM  
ACO-1 WELL HISTORY

DESCRIPTION OF WELL AND LEASE

Operator: license # 5591  
name Wes Tech Energy  
address R 4, #101  
City/State/Zip Great Bend, Kansas 67530  
Operator Contact Person Catherine Pekarek  
Phone (316) 792-5653  
Contractor: license # 5122  
name Woodman-Iannitti Drilling Co  
Wellsite Geologist David P. Williams  
Phone (316) 792-5020

Designate Type of Completion

New Well  Re-Entry  Workover

Oil  SWD  Temp Abd  
 Gas  Inj  Delayed Comp.  
 Dry  Other (Core, Water Supply etc.)

If OWWO: old well info as follows:

Operator  
Well Name  
Comp. Date Old Total Depth

WELL HISTORY

Drilling Method:  Mud Rotary  Air Rotary  Cable  
8/17/84 8/23/84 8/23/84  
Spud Date Date Reached TD Completion Date

3670'  
Total Depth PBTB

Amount of Surface Pipe Set and Cemented at 870' feet

Multiple Stage Cementing Collar Used?  Yes  No

If Yes, Show Depth Set feet

If alternate 2 completion, cement circulated from feet depth to w/ SX cmt

API NO. 15-009-23,663-0000

County Barton

NE NE SW Sec 25 Twp 20 Rge 15  
(location)  East  West

2310 Ft North from Southeast Corner of Section  
2970 Ft West from Southeast Corner of Section  
(Note: locate well in section plat below)


Lease Name Smith 1-25 Well# 1

Field Name Unruh South EXT (1/8 W)

Producing Formation Arbuckle

Elevation: Ground 1914 KB 1919

Section Plat

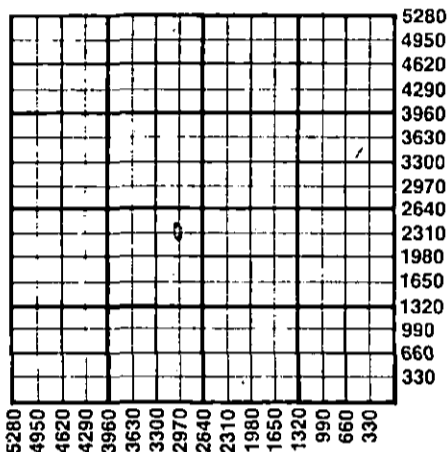

WATER SUPPLY INFORMATION

Source of Water:  
Division of Water Resources Permit #

Groundwater Ft North From Southeast Corner and  
(Well) Ft. West From Southeast Corner of  
Sec Twp Rge  East  West

Surface Water Ft North From Southeast Corner and  
(Stream, Pond etc.) Ft West From Southeast Corner  
Sec Twp Rge  East  West

Other (explain)  
(purchased from city, R.W.D.#)

Disposition of Produced Water:  Disposal  Repressuring

Docket # CD118214(C-21526)

INSTRUCTIONS: This form shall be completed in duplicate and filed with the Kansas Corporation Commission, 200 Colorado Derby Building, Wichita, Kansas 67202, within 90 days after completion or recompletion of any well. Rules 82-3-130 and 82-3-107 apply.

Information on side two of this form will be held confidential for a period of 12 months if requested in writing and submitted with the form. See rule 82-3-107 for confidentiality in excess of 12 months.

One copy of all wireline logs and drillers time log shall be attached with this form. Submit CP-4 form with all plugged wells. Submit CP-111 form with all temporarily abandoned wells.

RECEIVED

STATE CORP COM

All requirements of the statutes, rules, and regulations promulgated to regulate the oil and gas industry have been fully complied with and the statements herein are complete and correct to the best of my knowledge.

CONSERVATION DIVISION  
Wichita, Kansas


Signature Catherine E. Pekarek

Title President Date 10-2-84

Subscribed and sworn to before me this 2nd day of October 1984

Notary Public Dianne M. Willesden

Date Commission Expires 6-28-85

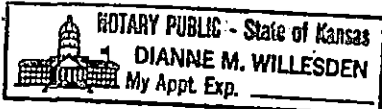

K.C.C. OFFICE USE ONLY  
F  Letter of Confidentiality Attached  
C  Wireline Log Received  
C  Drillers Timelog Received  
Distribution  
 KCC  SWD/Rep  NGPA  
 KGS  Plug  Other (Specify)

Form ACO-1  
(This form supercedes previous forms ACO-1 & C-10)

Sec. 25 Twp. 20 Rge. 15

Operator Name Wes-Tech Energy Co Lease Name Smith 1-25 Well# 1 SEC 25 TWP. 20 RGE. 15  East  West

**WELL LOG**

**INSTRUCTIONS:** Show important tops and base of formations penetrated. Detail all cores. Report all drill stem tests giving interval tested, time tool open and closed, flowing and shut-in pressures, whether shut-in pressure reached static level, hydrostatic pressures, bottom hole temperature, fluid recovery, and flow rates if gas to surface during test. Attach extra sheet if more space is needed. Attach copy of log.

Drill Stem Tests Taken  Yes  No  
 Samples Sent to Geological Survey  Yes  No  
 Cores Taken  Yes  No

Formation Description  
 Log  Sample

Sand	0	70
Shale	70	195
Shale	195	285
D Sand	285	388
Shale & Red Bed	388	800
Shale	800	862
Anhy	862	874
Anhy	874	1145
Shale	1145	1820
Shale	1820	2190
Shale	2190	2510
Shale	2510	2810
Shale & Lime	2810	3048
Shale & Lime	3048	3185
Shale & Lime	3185	3240
Lime	3240	3286
Lime	3286	3520
Lime	3520	3638
Lime	3638	3643
Lime	3543	3670
Lime	3670	

Name	Top	Bottom
Heebner	3212'	(-1293)
Toronto	3231'	(-1312)
Douglas	3248'	(-1329)
Iatan	3312'	(-1393)
Lansing	3319'	(-1400)
Drum	3347'	(-1528)
Base K.C.	3543'	(-1624)
Conglomerate	3562'	(-1643)
Simpson Shale	3592'	(-1673)
Arbuckle	3634	(-1716)

DST #1

Interval 3588' to 3638'. 1st Blow weak building to strong in 9 minutes. 2nd Blow strong blow G.T.S. in 30 min. Maximum gauge 8,950 MCF. Recovery: 50' O&GCM (17% Oil, 55% Mud, 28% Gas) 120' O&GCM (37% Oil, 43% Mud, 20% Gas) 240' O&GCM (37% Oil, 27% Muc, 36% Gas) 60' Froggy Oil (44% Oil, 9% Mud, 45% Gas) 470' Total Fluid

DST #1

Interval 3638' to 3643'. 1st Blow - Weak blow slowly building throughout 1/4" to 1" flushed tool. 2nd Blow - No blow, flushed tool, no help. Recovery: 200' SOCM (3% Oil, No Water).

CASING RECORD <input type="checkbox"/> new <input type="checkbox"/> used							
Report all strings set - conductor, surface, intermediate, production, etc.							
Purpose of string	size hole drilled	size casing set (in O.D.)	weight lbs/ft.	setting depth	type of cement	# sacks used	type and percent additives
Surface	12-1/4"	8-5/8"	23 & 20#	870'	60/40 Poz	450	2% Gel, 3% CC
Production	7-7/8"	5-1/2"	14#	3669'	Common	125	1000 Gal Mud Swp
PERFORATION RECORD				Acid, Fracture, Shot, Cement Squeeze Record			
shots per foot	specify footage of each interval perforated			(amount and kind of material used)			Depth
2	3636' - 3638'			Acidized 250 gallons mud acid			3636-3638
"2 Shots/6"	3636' - 3638'			Squeezed with 150 sacks cement			3636-3638
2	3637' - 3639			Reacidized 250 gallons mud acid			3637-3639
				Acidized 500 gallons mud acid			3637-3639
				Reacidized 1,000 gal. 15% NE acid			3637-3639
TUBING RECORD				Liner Run <input type="checkbox"/> Yes <input checked="" type="checkbox"/> No			
Date of First Production		Producing method					
9-13-84		<input type="checkbox"/> flowing <input checked="" type="checkbox"/> pumping <input type="checkbox"/> gas lift <input type="checkbox"/> Other (explain)					
Estimated Production Per 24 Hours	Oil	Gas	Water	Gas-Oil Ratio	Gravity		
	12 Bbls	MCF	37 Bbls	CFPB	35		

Disposition of gas:  vented  sold  used on lease

METHOD OF COMPLETION  open hole  perforation  other (specify) \_\_\_\_\_

PRODUCTION INTERVAL  Dually Completed  Commingled