

# COPY

SIDE ONE

# CONFIDENTIAL

STATE CORPORATION COMMISSION OF KANSAS  
 OIL & GAS CONSERVATION DIVISION  
 WELL COMPLETION FORM  
 ACO-1 WELL HISTORY  
 DESCRIPTION OF WELL AND LEASE

API NO. 15- 009-24,468-0000

County Barton  
 75 N of  
 SW SE NE Sec. 7 Twp. 20S Rge. 15  East West

Operator: License # 4767

3045 Ft. North from Southeast Corner of Section

Name: Ritchie Exploration, Inc.

990 Ft. West from Southeast Corner of Section  
 (NOTE: Locate well in section plat below.)

Address 125 N. Market, Suite 1000

Lease Name Deckert Well # 1

City/State/Zip Wichita, KS 67202

Field Name Pawnee Rock

Purchaser: n/a

Producing Formation n/a

Operator Contact Person: Bob Mathiesen

Elevation: Ground 2023' KB 2028'

Phone ( 316 ) 267-4375

Total Depth 3900' PBTD n/a

Contractor: Name: Allen Drilling Co.

License: 5418

Wellsite Geologist: Bob Mathiesen

Designate Type of Completion  
 New Well  Re-Entry  Workover

Oil  SWD  Temp. Abd.  
 Gas  Inj  Delayed Comp.  
 Dry  Other (Core, Water Supply, etc.)

If OWO: old well info as follows:

Operator: \_\_\_\_\_

Well Name: \_\_\_\_\_

Comp. Date \_\_\_\_\_ Old Total Depth \_\_\_\_\_


Drilling Method:  
 Mud Rotary  Air Rotary  Cable

4/09/91 4/17/91 4/18/91  
 Spud Date Date Reached TD. Completion Date

PLEASE KEEP THIS INFORMATION CONFIDENTIAL

MAY 24 1991

CONSERVATION DIVISION  
 Wichita, Kansas

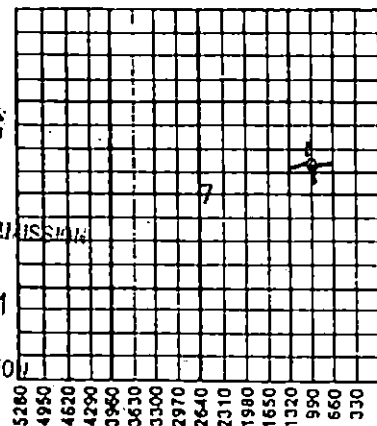

5280  
4950  
4620  
4290  
3960  
3630  
3300  
2970  
2640  
2310  
1980  
1650  
1320  
990  
660  
330

AIT I D & A

Amount of Surface Pipe Set and Cemented at 1042' Feet

Multiple Stage Cementing Collar Used?  Yes  No

If yes, show depth set \_\_\_\_\_ Feet

If Alternate II completion, cement circulated from 1042'

feet depth to surface w/ 400 sx cmt.

INSTRUCTIONS: This form shall be completed in triplicate and filed with the Kansas Corporation Commission, 200 Colorado Derby Building, Wichita, Kansas 67202, within 120 days of the spud date of any well. Rule 82-3-130, 82-3-107 and 82-3-106 apply. Information on side two of this form will be held confidential for a period of 12 months if requested in writing and submitted with the form. See rule 82-3-107 for confidentiality in excess of 12 months. One copy of all wireline logs and drillers time log shall be attached with this form. ALL CEMENTING TICKETS MUST BE ATTACHED. Submit CP-4 form with all plugged wells. Submit CP-111 form with all temporarily abandoned wells. Any recompletion, workover or conversion of a well requires filing of ACO-2 within 120 days from commencement date of such work.

All requirements of the statutes, rules and regulations promulgated to regulate the oil and gas industry have been fully complied with and the statements herein are complete and correct to the best of my knowledge.

Signature [Signature]

Title President Date 5/17/91

Subscribed and sworn to before me this 17th day of May, 19 91.

Notary Public [Signature]

Date Commission Expires 6/07/92

LINDA K. RICE  
 NOTARY PUBLIC  
 STATE OF KANSAS  
 My Appl. Exp. 6/7/92

K.C.C. OFFICE USE ONLY

F  Letter of Confidentiality Attached  
 C  Wireline Log Received  
 C  Drillers Timelog Received

Distribution  
 KCC  SWD/Rep  NCPA  
 KGS  Plug  Other  
 (Specify)

21