


WELL PLUGGING RECORD

Give All Information Completely
Make Required Affidavit
Mail or Deliver Report to:
Conservation Division
State Corporation Commission
211 No. Broadway
Wichita, Kansas

Ness County, Sec. 14 Twp. 20S Rge. (E) 24 (W)
Location as "NE/CNW/SW" or footage from lines C NE NE
Lease Owner Aspen Drilling, Inc.
Lease Name Petersillie Well No. #1
Office Address Box 783 Great Bend, Kansas
Character of Well (completed as Oil, Gas or Dry Hole) Dry Hole
Date well completed January 2, 1972
Application for plugging filed January 2, 1972
Application for plugging approved January 2, 1972
Plugging commenced January 2, 1972
Plugging completed January 2, 1972
Reason for abandonment of well or producing formation Dry Hole

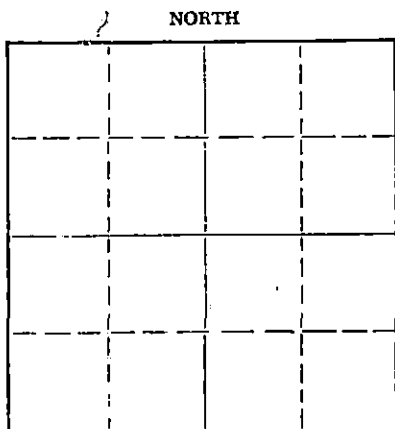

Locate well correctly on above Section Plat

If a producing well is abandoned, date of last production 19____
Was permission obtained from the Conservation Division or its agents before plugging was commenced? Yes

Name of Conservation Agent who supervised plugging of this well Leo Massey
Producing formation _____ Depth to top _____ Bottom _____ Total Depth of Well 4430' Feet
Show depth and thickness of all water, oil and gas formations.

OIL, GAS OR WATER RECORDS

CASING RECORD

FORMATION	CONTENT	FROM	TO	SIZE	PUT IN	PULLED OUT
				8 5/8"	292.50'	-0-

Describe in detail the manner in which the well was plugged, indicating where the mud fluid was placed and the method or methods used in introducing it into the hole. If cement or other plugs were used, state the character of same and depth placed, from _____ feet to _____ feet for each plug set.

Plug @ 600' 70 sx. Cement Fluid to 240' 20 sx. Cement
Plug @ 40' 1/2 sx. Halls 10 sx. Cement

RECEIVED
STATE CORPORATION COMMISSION
JAN 7 1972
CONSERVATION DIVISION
Wichita, Kansas

(If additional description is necessary, use BACK of this sheet)
Name of Plugging Contractor Leben Drilling, Inc.
Address 100 Park Ave. Bldg. Oklahoma City, Oklahoma 73102

STATE OF Oklahoma, COUNTY OF Oklahoma, ss.
Betty Presley (employee of owner) or (owner or operator) of the above-described well, being first duly sworn on oath, says: That I have knowledge of the facts, statements, and matters herein contained and the log of the above-described well as filed and that the same are true and correct. So help me God.

(Signature) Betty Presley

(Address)

SUBSCRIBED AND SWORN TO before me this 5th day of January, 1977

My commission expires December 16, 1975
Leslie M. Kite Notary Public.

WELL LOG

15.135.20546.0000

Company Aspen Drilling, Inc.

Sec. 14 T. 20S R. 24W

Contractor Leben Drilling, Inc.

Loc. C NE NE

Farm Petersillie #1

County Ness County


Total Depth 4430'

Casing 8 5/8"

Commenced December 23, 1971

Production

Completed January 2, 1972

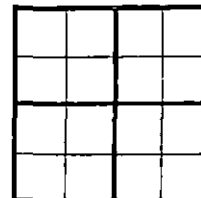

Figures Indicate Bottom of Formations

0' - 255' surface clay & red bed
 255' - 940' shale
 940' - 955' stone coral
 955' - 1010' red bed
 1010' - 1230' sand
 1230' - 1300' shale & sand
 1300' - 1638' lime & shale
 1638' - 1733' shale & lime
 1733' - 2370' lime & shale
 2370' - 2428' lime
 2428' - 2554' shale & lime
 2554' - 2930' lime & shale
 2930' - 3060' shale
 3060' - 3586' shale & lime
 3586' - 4070' lime & shale
 4070' - 4430' lime

RECEIVED
 STATE CORPORATION COMMISSION
 JAN 7 1972
 CONSERVATION DIVISION
 Wichita, Kansas

State of Oklahoma
 County of Oklahoma } SS

I, Betty Presley of Leben Drilling, Inc., upon oath state that the above and foregoing is a true and correct copy of the log of the Petersillie #1 Well.

Betty Presley

Subscribed and sworn to before me this 5th day of January, 1972

My Commission Expires: Dec. 16, 1975 Loelie M. Kates