

WELL PLUGGING RECORD

Give All Information Completely
Make Required Affidavit
Mail or Deliver Report to:
Conservation Division
State Corporation Commission
212 North Market, Insurance Bldg.
Wichita, Kansas

Ness County, Sec. 14 Twp. 20S Rge. 24 (E) (W)

Location as "NE/CNW/SW" or footage from lines SE SW NW

Lease Owner Alco Oil and Gas Corporation

Lease Name Petersilie "B" 2 Well No. 2

Office Address 533 Petroleum Building, Wichita, Kansas

Character of Well (completed as Oil, Gas or Dry Hole) Oil

Date well completed June 6 19 59

Application for plugging filed May 23 19 60

Application for plugging approved May 23 19 60

Plugging commenced May 31 19 60


Plugging completed June 3 19 60

Reason for abandonment of well or producing formation

non-commercial

If a producing well is abandoned, date of last production 5/8/60 19

Was permission obtained from the Conservation Division or its agents before plugging was commenced? Yes

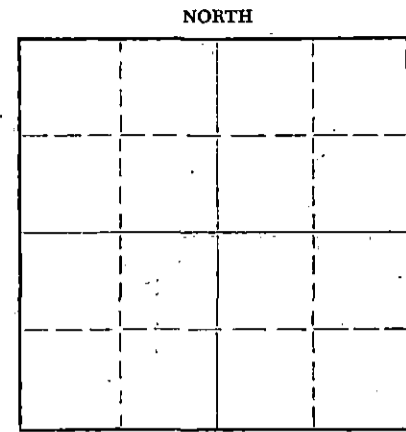

Locate well correctly on above Section Plat

Name of Conservation Agent who supervised plugging of this well Gilbert Leiker

Producing formation Miss. Depth to top _____ Bottom _____ Total Depth of Well 4490 Feet

Show depth and thickness of all water, oil and gas formations.

OIL, GAS OR WATER RECORDS

CASING RECORD

FORMATION	CONTENT	FROM	TO	SIZE	PUT IN	PULLED OUT
				8-5/8"	550'	None
				5-1/2"	4489'	2697'

Describe in detail the manner in which the well was plugged, indicating where the mud fluid was placed and the method or methods used in introducing it into the hole. If cement or other plugs were used, state the character of same and depth placed, from _____ feet to _____ feet for each plug set.

Plugged back w/sand 4459' to 4400'; mixed and dumped 5 sacks cement from 4400' 4360'. Pulled 2697' 5-1/2" Casing. Mixed and pumped 20 sacks Gel Mud; put in plug. Mixed and pumped in 75 sacks cement from 225' to base of cellar.

RECEIVED
STATE CORPORATION COMMISSION
AUG 18 1960
CONSERVATION DIVISION
Wichita, Kansas

(If additional description is necessary, use BACK of this sheet)

Name of Plugging Contractor Ace Pipe Pulling Company

Address P. O. Box 304, Great Bend, Kansas

STATE OF Kansas COUNTY OF Sedgwick, ss.

Donald R. Douglass (employee of owner) or (owner or operator) of the above-described

well, being first duly sworn on oath, says: That I have knowledge of the facts, statements, and matters herein contained and the log of the above-described well as filed and that the same are true and correct. So help me God.

(Signature) Donald R. Douglass

Donald R. Douglass

533 Petroleum Building, Wichita, Kansas
(Address)

SUBSCRIBED AND SWORN to before me this 16 day of August 19 60

Betty Baker Notary Public.

My commission expires 2/23/64

Re.

DRILLERS LOG

Petersilie "B" #2

CASING RECORD: 8 5/8" @ 547' w/300 sx Sunset
 COMPANY: Artnell Company
 DESCRIPTION: SE SW NW 14-20S-24W Ness County, Kansas
 CONTRACTOR: National Drilling Co., Inc.
 COMMENCED: May 19, 1959
 ELEVATION: 2340 KB 2338 DF
 COMPLETED: June 1, 1959

TOTAL DEPTH: 4490' (-2150)

<u>FORMATION</u>	<u>FROM</u>	<u>TO</u>	<u>REMARKS</u>
Surface Clay	0	20	
Shale	20	550	
Shale & Redbed	550	700	
Redbed	700	1180	
Sand & Shale	1180	1275	
Shale & Shells	1275	2380	
Shale	2380	2595	
Lime & Shale	2595	2695	
Lime	2695	3080	
Lime & Shale	3080	3175	
Shale & Shells	3175	3295	
Lime & Shale	3295	3495	
Chalk & Shale	3495	3600	
Lime & Shale	3600	3730	
Lime	3730	4014	
Drilling Break	4014	4034	
Lime	4034	4490	

RECEIVED
 STATE CORPORATION COMMISSION

AUG 24 1960

CONSERVATION DIVISION
 Wichita, Kansas

I certify that this is a true and correct copy of the above log to the best of my knowledge.

NATIONAL DRILLING COMPANY, INC.

Howard A. Stoskopf
 Howard A. Stoskopf

Subscribed and sworn to before me this 16th day of July, 1959.

Ruby Gourley
 Notary Public

RUBY GOURLEY
 My commission expires July 13, 1960