


STATE OF KANSAS
STATE CORPORATION COMMISSION

WELL PLUGGING RECORD

Give All Information Completely
Make Required Affidavit
Mail or Deliver Report to
Conservation Division
State Corporation Comm.
245 North Water
Wichita, KS 67202

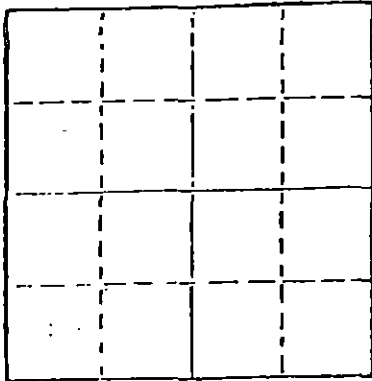

Locate well correctly on above
Section Plat

Barton County. Sec. 12 Twp. 20 Rge. 15 E/W
Location as "NE/CNW $\frac{1}{4}$ SW $\frac{1}{4}$ " or footage from lines
Approx NE NW NE

Lease Owner Strata Drilling Co.
Lease Name Strobel Well No. 1
Office Address P.O. Box 355, Great Bend, Kansas 67530
Character of Well (Completed as Oil, Gas or Dry Hole) Dry Hole

Date Well completed March 11 1977
Application for plugging filed March 11 1977
Application for plugging approved March 11 1977
Plugging commenced March 11 1977
Plugging completed March 11 1977

Reason for abandonment of well or producing formation Dry Hole

If a producing well is abandoned, date of last production 19

Was permission obtained from the Conservation Division or its agents before plugging was commenced? yes

Name of Conservation Agent who supervised plugging of this well Duane Rankin
Producing formation Depth to top Bottom Total Depth of Well 3650'
Show depth and thickness of all water, oil and gas formations.

OIL, GAS OR WATER RECORDS

CASING RECORD

FORMATION	CONTENT	FROM	TO	SIZE	PUT IN	PULLED OUT

Describe in detail the manner in which the well was plugged, indicating where the mud fluid was placed and the method or methods used in introducing it into the hold. If cement or other plugs were used, state the character of same and depth placed, from feet to feet for each plug set.

Bottom plug at 420' w/40 sacks cement thru drill pipe.

Top plug @ 40' w/ $\frac{1}{2}$ sack hulls and 10 sacks cement.

2 sacks cement in rat hole

RECEIVED
STATE CORPORATION COMMISSION

MAR 16 1977

CONSERVATION DIVISION
Wichita, Kansas

(If additional description is necessary, use BACK of this sheet)

Name of Plugging Contractor Duke Drilling Co.

STATE OF KANSAS COUNTY OF BARTON, ss.

Leonard Williamson

(employee of owner) or (owner/operator)

of the above-described well, being first duly sworn on oath, says: That I have knowledge of the facts, statements, and matters herein contained and the log of the above-described well as filed and that the same are true and correct. So help me God.

(Signature)

Leonard Williamson

Box 823, Great Bend, Kansas 67530

(Address)

SUBSCRIBED AND SWORN TO before me this 14th day of March, 1977

My commission expires April 11, 1978

Lorothy M. Hague
Notary Public.

15009.21130.0000

DRILLERS' WELL LOG

DATE COMMENCED: March 4, 1977
DATE COMPLETED: March 11, 1977

Strata Drilling Co.
STROBEL # 1
Approx NE NW NE
Sec 12-T20-R15W
Barton County, Kansas

0 - 348' Surface Soil, Clay, Shale w/Sand Streaks
348 - 548' D. Sand
548 - 919' Shale, Red Bed
919 - 948' Anhydrite
948 - 1231' Red Bed and Shale
1231 - 1835' Shale, Lim, Sand Streaks
1835 - 2915' Lime and Shale
2915 - 3231' Lime
3231 - 3235' Shale
3235 - 3264' Lime
3264 - 3318' Shale
3318 - 3330' Lime and Shale
3330 - 3592' Lime
3592 - 3642' Lime, Shale, Chert and Sand
3642 - 3650' Dolomite
3650' RTD

ELEVATION: 1963 K.B.

FORMATION TOPS

Topeka	2915
Heebner	3231
Toronto	3253
Douglas	3264
Brown Lime	3318
Kansas City	3330
Conglomerate	3592
Arbuckle	3642
RTD	3650

SURFACE PIPE:

Ran used 8 5/8", 23# pipe
at 931' w/385 sacks 50/50
Pozmix, 2% Gel, 3% cc.

AFFIDAVIT

STATE OF KANSAS }
COUNTY OF BARTON } ss.

Leonard Williamson, of lawful age, does swear and state that the facts and statements herein contained are true and correct to the best of his knowledge.

Leonard W. Williamson

Subscribed and sworn to before me this 14th day of March, 1977.

Dorothy M. Hague
Notary Public

My Commission Expires: April 11, 1978

RECEIVED
KANSAS COMMISSION

MAR 16 1977

C. L. H. H. H.
Wichita, Kansas