

DISTRICT CONSERVATION AGENT'S REPORT

TO:

State Corporation Commission
Conservation Division
211 North Broadway
Wichita, Kansas

FILE NO. 139-25LOCATION SE SW NW.SEC. 7 TWP. 20 RGE. 15WDry Hole Abandoned Oil Well Abandoned Gas Well ✓

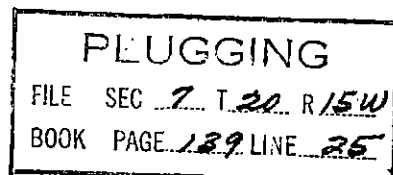
I have this date completed supervision of plugging of:

Well No. 2 Lease DisksOperator Bess F. Brack Oil Co. Address 309 Brown Bldg, WichitaField County BartonTotal Depth 3726 Feet.Plugging Contractor E + L Casing Pulling Co.Plugging Contractor's License No. 249Address 1003 Heiser Great Bend Kansas

(Describe Briefly the manner in which the well was plugged)

Surf Pipe 8 3/8 @ 1020 cu 425 cu cent.
4 1/2 @ 3720 cu 125 cu cent.
top Perf. at 3700 — Sand to 3690-4 cu.
Pull Pipe fill hole with heavy mud
to 3750 r.b. and 20 cu cent.
and heavy mud to 35 feet r.b. and 10 cu.
cent. to base of cellar

A.M. Burmester
District Conservation Agent

Date Feb 16 - 1957

RECEIVED
STATE CORPORATION

2-18-1957
CONSERVATION DIVISION
Wichita, Kansas