

STATE OF KANSAS
STATE CORPORATION COMMISSION


WELL PLUGGING RECORD

OR
FORMATION PLUGGING RECORD

Strike out upper line
when reporting plugging
of formations.

Give All Information Completely
Make Required Affidavit
Mail or Deliver Report to:
Conservation Division
State Corporation Commission
800 Bitting Building
Wichita, Kansas

NORTH

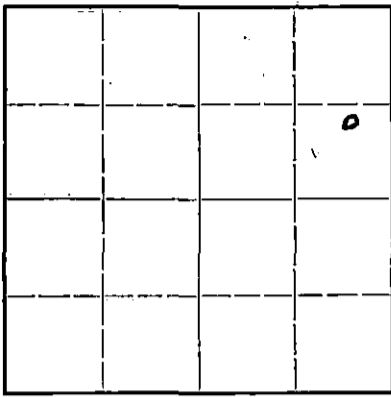

Locate well correctly on above
Section Plot

.....Barton.....County. Sec.....17 Twp.....20 Rge.....(E) 15 (W)
Location as "NE $\frac{1}{4}$ NW $\frac{1}{4}$ SW $\frac{1}{4}$ " or footage from lines 660' from west from east line
Lease Owner Table Mesa Oil Co. 330' south from north line S.E. $\frac{1}{4}$
Lease Name Max Smith Well No. I
Office Address Box 86 Colorado Springs Colorado
Character of Well (completed as Oil, Gas or Dry Hole) Dry Hole
Date well completed 10/16/47 19
Application for plugging filed 10/16/47 Verbal 19
Application for plugging approved 10/16/47 Verbal 19
Plugging commenced 10/16/47 19
Plugging completed 10/16/47 19
Reason for abandonment of well or producing formation Dry Hole

If a producing well is abandoned, date of last production X 19
Was permission obtained from the Conservation Division or its agents before plugging was com-
menced? Yes

Name of Conservation Agent who supervised plugging of this well H. W. Kerr
Producing formation None Depth to top X Bottom X Total Depth of Well 3910 Feet
Show depth and thickness of all water, oil and gas formations.

OIL, GAS OR WATER RECORDS

CASING RECORD

Formation	Content	From	To	Size	Put In	Pulled Out
Surface sands & Soils	Water	Surface	275'	8 5/8	1080'	None

Describe in detail the manner in which the well was plugged, indicating where the mud fluid was placed and the method or methods used in introducing it into the hole. If cement or other plugs were used, state the character of same and depth placed, from.....feet to.....feet for each plug set.

Hole filled with heavy mud from 3910' back to 1080'
Set Bridge at 1080 and Dumped 15 Sx Cement
Pumped Hole full heavy mud and set wood plug at 100' 30' and dumped 15 Sx cement
Filling bottom surface pipe and bottom cellar

(If additional description is necessary, use BACK of this sheet)

Correspondence regarding this well should be addressed to Harbar Drilling Co. 10-21-1947
Address 1019 Central Bldg. Wichita Kansas


STATE OF ///part// Kansas, COUNTY OF Barton, ss.
J. E. Trimble (employee of owner) or (owner or operator) of the above-described well,
being first duly sworn on oath, says: That I have knowledge of the facts, statements, and matters herein contained and the log of the above-described well as filed and that the same are true and correct. So help me God.

(Signature) J. E. Trimble

(Address)

SUBSCRIBED AND SWORN to before me this 17 day of oct, 1947
U.E. Hagelman
Notary Public.

My commission expires 30 Aug 1950

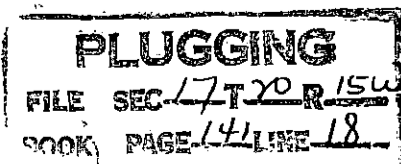

SMITH #1

60 feet from the East Line and 330 feet from the North line of SE $\frac{1}{4}$ NE $\frac{1}{4}$ Sec. 17-20-15W, Barton County, Kansas.

Rigging up Rotary tools 9-30-47
Tearing down Rotary tools 10-17-47

Run 38 Jts. 1085' of 8-5/8" surface pipe.
Set @ 1080', cemented with 525 sacks of cement.

<u>FORMATION</u>	<u>FROM</u>	<u>TO</u>
Surface clay	0	60
Shale	60	130
Shale and red bed	130	460
Sand	460	590
Red bed	590	610
Sand	610	845
Red bed and shells	845	1052
Anhydrite	1052	1100
Shale and shells	1100	1585
Salt	1585	1745
Shale and lime	1745	2235
Lime	2235	2270
Shale and lime	2270	3580
Lime, broken	3580	3610
Lime	3610	3630
Shale and lime	3630	3675
Lime	3675	3780
Conglomerate & lime	3780	3830
Conglomerate	3830	3836
Lime and Chert	3836	3885
Conglomerate and Dolomite	3885	3904
Arbuckle	3904	3910 Total Depth

I, Don S. Packer, hereby certify the above Log is true and correct to the best of my knowledge and belief.

Don S. Packer

Subscribed and sworn to before me this 31st day of October, 1947.

(SEAL)

Mary R. Brann
Notary Public

My commission expires: Dec. 23, 1950

PLUGGING
FILE SEC 17 T 20 N 15W
BOOK PAGE 141 LINE 18

