


WELL PLUGGING RECORD

Give All Information Completely
Make Required Affidavit
Mail or Deliver Report to:
Conservation Division
State Corporation Commission
800 Bitting Building
Wichita, Kansas

Barton County, Sec. 16 Twp. 20S Rge. 15W (E) (W)

Location as "NE/CNW&SWK" or footage from lines NE SE SE
Lease Owner The Texas Company
Lease Name P. J. Deckert Unit Well No. 1
Office Address 614 Bitting Building, Wichita, Kansas
Character of Well (completed as Oil, Gas or Dry Hole) Dry
Date well completed May 24 19 55
Application for plugging filed (Verbal 5-24) May 25 19 55
Application for plugging approved (Verbal 5-24) May 26 19 55
Plugging commenced May 24 19 55
Plugging completed May 24 19 55
Reason for abandonment of well or producing formation _____

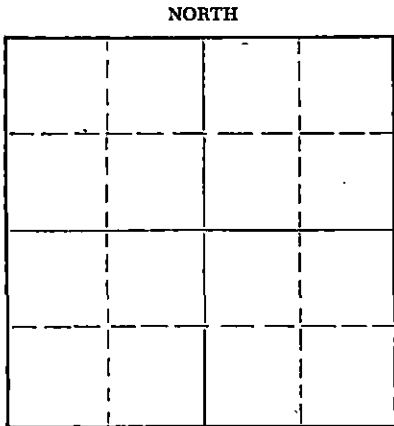

Locate well correctly on above Section Plat

If a producing well is abandoned, date of last production _____ 19 _____
Was permission obtained from the Conservation Division or its agents before plugging was commenced? Yes

Name of Conservation Agent who supervised plugging of this well Mr. Warren H. Horner
Producing formation _____ Depth to top _____ Bottom _____ Total Depth of Well 3825 Feet
Show depth and thickness of all water, oil and gas formations.

OIL, GAS OR WATER RECORDS

CASING RECORD

FORMATION	CONTENT	FROM	TO	SIZE	PUT IN	PULLED OUT
				10-3/4"	1015'	0'

Describe in detail the manner in which the well was plugged, indicating where the mud fluid was placed and the method or methods used in introducing it into the hole. If cement or other plugs were used, state the character of same and depth placed, from _____ feet to _____ feet for each plug set.

PLUGGED AS FOLLOWS:

3825' to 300' - Heavy Mud
300' to 250' - 10" Wooden Plug, 1/2 Sack
Hulls and 25 Sacks Cement
250-to 30' - Heavy Mud
30' to Bottom of Cellar - 10" Wooden Plug,
1/2 Sack Hulls and 15 Sacks Cement

(If additional description is necessary, use BACK of this sheet)

Name of Plugging Contractor Anschutz Drilling Company
Address 709 Union National Bank Building, Wichita, Kansas

STATE OF Kansas COUNTY OF Sedgwick, ss.
M. C. Harrell (employee of owner) or (owner or operator) of the above-described well, being first duly sworn on oath, says: That I have knowledge of the facts, statements, and matters herein contained and the log of the above-described well as filed and that the same are true and correct. So help me God.

(Signature) M. C. Harrell
614 Bitting Building, Wichita, Kansas
(Address)

SUBSCRIBED AND SWORN TO before me this 27th day of May 19 55

My commission expires Sept. 20, 1956

W. Howard Kistler Notary Public.

RECEIVED
STATE CORPORATION COMMISSION

JUL 7 - 1955

PLUGGING
FILE SEC 16 TWP 20 R 15W
BOOK 122 LINE 8

CONSERVATION DIVISION

6-7-1955

LOG OF WELL

FORM PO-214 SHEET 1 (4-54) 35M

P. J. DECKERT UNIT NO. 1

SHEET **1**

OWNER The Texas Company DIVISION Oklahoma DATE MADE June 1, 1955
 DISTRICT Kansas LEASE P. J. Deckert Unit WELL NO. 1
 STATE Kansas COUNTY OR PARISH Barton TWP. 20S RANGE 15W SEC. 16
 LOCATION OF WELL NE SE SE

COMMENCED RIGGING UP 5-11-55 COMMENCED DRILLING 5-12-55 COMPLETED DRILLING 5-25-55
 DAY DRILLER _____ NIGHT DRILLER _____ CONTRACTOR Anschutz Drlg. Co.
 CABLE FROM _____ TO _____ ROTARY FROM 0' TO 3825' COMPANY RIG NO. _____
 TOTAL DEPTH 3825' MEASURED BY M. C. Harrell ELEVATION KB - 2016
BF - 2013
GL - 2011

CASING RECORD

SIZE	WEIGHT	PUT IN WELL		PULLED OUT		LOST IN WELL		SHOES		PACKERS		
		FEET	INS.	FEET	INS.	FEET	INS.	LENGTH	MAKE	KIND	LENGTH	SET AT
<u>10-3/4"</u>	<u>32.75#</u>	<u>1015'</u>						<u>(R-2, H-40, new casing)</u>				<u>FT.</u>
												<u>FT.</u>
												<u>FT.</u>
<u>10-3/4" casing set at 1006' with 500 sacks cement, 1% CC. Cement circulated.</u>												

WAS CASING CEMENTED? _____ IF SO, HOW MANY SACKS OF CEMENT USED? _____
 LINER: STATE SIZE AND WEIGHT _____ WHERE SET _____ FT. AND INS. BLANK _____ FT. AND INS. PERFORATED _____
 HOW PUT TOGETHER _____ COUPLING _____ FLUSH JOINT _____ INSERTED _____
 REMARKS: _____

EQUIPMENT RECORD

TUBING		SUCKER RODS				PUMPING OUTFIT	
SIZE	WEIGHT	FEET	INS.	FEET	INS.	SIZE AND KIND	DESCRIPTION, KIND, SIZE, ETC.
<u>Completed Plugging 5-25-55</u>							

FLOWING, PUMPING, GASSER OR DRY Dry PRODUCTION FIRST 24 HOURS _____ PRODUCTION SETTLED _____
 IF GAS WELL, OPEN FLOW CAPACITY _____ SHUT IN PRESSURE _____ ROCK PRESSURE _____
 KIND OF SHOT _____ SIZE OF SHOT, QUARTS _____
 NUMBER OF SHELLS _____ SIZE OF SHELLS _____ INCHES, DIAMETER _____
 LENGTH OF SHELLS _____ FEET _____ INCHES _____ TOP OF SHOT _____
 BOTTOM OF SHOT _____ ANCHOR _____ WELL BRIDGED TO _____
 TOTAL DEPTH OF WELL _____ NUMBER OF SHOT _____ PRODUCTION BEFORE SHOT _____ BBLs. PER DAY _____
 PRODUCTION AFTER SHOT _____ BBLs. PER DAY, SHOT FURNISHED BY _____
 NAME OF SHOOTER _____ SHOT INSPECTED _____ BY _____ (COMPANY EMPLOYEE)
 COMMENCED DRILLING DEEPER _____ COMPLETED _____ DRILLING DEEPER _____

TOTAL DEPTH _____ PRODUCTION FIRST 24 HOURS _____ PRODUCTION SETTLED _____
 REMARKS: RECEIVED
STATE GEOLOGICAL COMMISSION
JUN 7 1955
CONSERVATION DIVISION
P. J. Deckert Unit #1
Rank-Wildcat
TD 3825'
Completed Drilling 5-25-55
Completed Testing 5-25-55

NOTE: IF WELL WAS DRY, STATE UNDER REMARKS, WHEN, HOW, AND BY WHOM PLUGGED.
 STATE UNDER REMARKS ANYTHING OF INTEREST NOT COVERED IN LOG.
 IF THE SPACE PROVIDED FOR REMARKS IS NOT SUFFICIENT WRITE ON BOTTOM OF LAST SHEET OF LOG.

PLUGGING
 FILE SEC 16-20-15W
 BOOK PAGE 122 LINE 8

TOTAL NUMBER OF SHEETS _____

LOG OF WELL

SHEET No. 2

District Kansas Owner The Texas Company Farm P. J. Deckert unit Well No. 1

FORMATION	AMOUNT	COLOR	HARD OR SOFT	DEPTH CORES TAKEN	REMARKS
REMARKS:					
5-22-55					Ran DST #1 from 3505-17', open 1 hour, strong blow thru-out test, recovered 1980' salt water. SIBHP 1200# in 30 minutes.
5-25-55					Drilled to 3825' in Lime. Ran Schlumberger Survey. Well non-commercial. Plugged and abandoned.
TOPS:					
Cimaron Dolomite-- 996					
Topeka-----3008					
Heebner-----3341					
Toronto-----3359					
Douglas-----3373					
Brown Lansing----3432					
Lansing-----3443					
Base Kansas City--3660					
Conglomerate-----3692					
Arbuckle-----3782					

RECEIVED
STATE CORPORATION COMMISSION

JUN 7

CONSERVATION

D R I L L E R ' S L O G

The Texas Company
P. J. Deckert Unit #1
NE SE SE 16-20S-15W
Barton County, Kansas

<u>TO</u>	<u>FROM</u>	
0	75	Surface Clay & Sand
75	310	Shale & Sand
310	385	Shale & Shells
385	525	Sand
525	997	Red Rock
0	485	Reaming
485	930	Reaming
930	997	Red Rock
997	1022	Anhydrite
1022	1515	Red Rock & Shale
1515	1815	Salt, Shale, Shells
1815	2294	Lime & Shale
2294	2500	Shale & Lime
2500	2575	Shale & Shells
2575	3180	Shale & Lime
3180	3286	Lime & Shale
3286	3335	Lime
3335	3420	Lime & Shale
3420	3700	Lime
3700	3735	Lime, Shale & Chert
3735	3809	Conglomerate
3809	3825	Arbuckle
	3825	ROTARY TOTAL DEPTH

COMMENCED: 5-12-55
COMPLETED: 5-24-55

CASING RECORD:

Set 1006' of 10 3/4" surface casing with 500 sacks cement.

D & A

STATE OF KANSAS)
) SS
COUNTY OF SEDGWICK)

I hereby affirm that the above and foregoing is a true and correct copy of the log of the P. J. Deckert Unit #1 located NE SE SE of Section 16-20S-15W, Barton County, Kansas.

ANSCHUTZ DRILLING CO., INC.

BY: *E. G. Koelling*
E. G. Koelling
Vice-President

Subscribed and sworn to before me this 26th day of May, 1955

Charles E. Barlow
Notary Public
STATE OF KANSAS

My Commission Expires: July 28, 1958.

CONCEIVED
L. W. H.