


WELL PLUGGING RECORD

Give All Information Completely
Make Required Affidavit
Mail or Deliver Report to:
Conservation Division
State Corporation Commission
800 Biting Building
Wichita, Kansas

NORTH

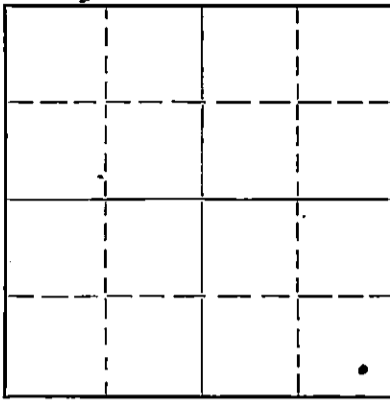

Locate well correctly on above
Section Plat

Barton County: Sec. 14 Twp. 20 Rge. (E) 15 (W)

Location as "NE/CNW $\frac{1}{4}$ SW $\frac{1}{4}$ " or footage from lines SE SE SE

Lease Owner Sinclair Oil & Gas Co

Lease Name Lillian Strobel Well No. 1

Office Address Box 521, Tulsa, Okla.

Character of Well (completed as Oil, Gas or Dry Hole) Gas Well

Date well completed Dec. 1 19 47

Application for plugging filed July 10 19 51

Application for plugging approved July 12 19 51

Plugging commenced July 24 19 51

Plugging completed Aug 11 19 51

Reason for abandonment of well or producing formation Gas has been depleted by
water flooding well

If a producing well is abandoned, date of last production March 19 51

Was permission obtained from the Conservation Division or its agents before plugging was commenced? Yes

Name of Conservation Agent who supervised plugging of this well C.D. Stough

Producing formation Arbuckle Depth to top 3596 Bottom Total Depth of Well 3647 Feet

Show depth and thickness of all water, oil and gas formations.

OIL, GAS OR WATER RECORDS

CASING RECORD

Formation	Content	From	To	Size	Put In	Pulled Out
Arbuckle Lime	water	3596	3647	8-5/8"	920'	0
				5-1/2"	3692'	1918'

Describe in detail the manner in which the well was plugged, indicating where the mud fluid was placed and the method or methods used in introducing it into the hole. If cement or other plugs were used, state the character of same and depth placed, from _____ feet to _____ feet for each plug set.

3647-3639' 5 sx cement
3639-3600' crushed rock
3600-3592' 5 sx cement
3592-250' mud
250-240' rock bridge
240-200' 15 sx cement
200-30' mud
30-20' rock bridge
20-0 10 sx cement

8-24-1951

RECEIVED
STATE CORPORATION COMMISSION

AUG 24 1951

CONSERVATION DIVISION
WICHITA, KANSAS

(If additional description is necessary, use BACK of this sheet)

Correspondence regarding this well should be addressed to Mr. E.H. Gibbons

Address Box 521, 551, Chase, Kas

STATE OF Kansas, COUNTY OF Rice, ss.

I, E.H. Gibbons, (employee of owner) or ~~owner or operator~~ of the above-described well,

being first duly sworn on oath, says: That I have knowledge of the facts, statements, and matters herein contained and the log of the above-described well as filed and that the same are true and correct. So help me God.

(Signature) *E.H. Gibbons*

Box 551, Chase, Kas

(Address)

SUBSCRIBED AND SWORN to before me this 22nd day of Aug, 19 51

My commission expires Aug 22 1953

PLUGGING
FILE SEC 14 T 20 R 15W
BOOK PAGE 94 LINE 23

B.R. Ritterhouse
Notary Public.

WELL LOG
Sinclair Oil & Gas Co

15.009.16599.0000

Lillian Strobel # 1
SE SE 14-20-15W, Barton Co., Kas
330' fm S & E lines
Elev. 1933 rig flr.

Drilling begun 11/16/1947
Drilling completed 12/1/1947.
T.D. drld 3693'
Top cmt plug 3673'
Later plugged back to 3647'

Drillers Log
Surface Level Measurement

Surface Soils	40
Sand & Shells	153
Sand & Gravel	253
Shale & Sand	410
Shale & Shells	475
Sand & Shale	505
Shale & Red Bed	655
Red Shale	790
Sand & Red Shale	855
Shale	909
Anhydrite	919
8-5/8" OD csg set at 915'	
Lime & Shale	955
Shale	970
Shale & Shells	1705
Shale & Lime	2065
Lime	2150
Lime & Shale	2255
Shale & Lime	2350
Lime & Shale	2710
Lime	2880
Lime & Shale	3065
Lime	3120
Shale	3165
Shale & Lime	3300
Shale	3356
Shale & Lime	3430
Lime	3693
Plugged back to 3647'	
5-1/2" set at 3693'	
Top Arbuckle 3596'	

