


STATE OF KANSAS  
STATE CORPORATION COMMISSION

WELL PLUGGING RECORD

Give All Information Completely  
Make Required Affidavit  
Mail or Deliver Report to  
Conservation Division  
State Corporation Comm.  
245 North Water  
Wichita, KS 67202

Barton County, Sec. 25 Twp. 20 Rge. 15 E/W  
Location as "NE/CNW $\frac{1}{2}$ SW $\frac{1}{2}$ " or footage from lines SW SE NE

Lease Owner National Oil Company  
Lease Name Ray #1 Well No.           
Office Address Hays, Kansas 67601  
Character of Well (Completed as Oil, Gas or Dry Hole)         

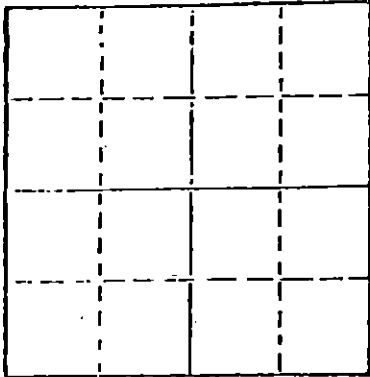

Locate well correctly on above  
Section Plot

Date Well completed          19           
Application for plugging filed          19           
Application for plugging approved          19           
Plugging commenced 2/16/77 19           
Plugging completed 2/21/77 19           
Reason for abandonment of well or producing formation depleted.

If a producing well is abandoned, date of last production          19         

Was permission obtained from the Conservation Division or its agents before plugging was commenced? yes

Name of Conservation Agent who supervised plugging of this well           
Producing formation          Depth to top          Bottom          Total Depth of Well 3628  
Show depth and thickness of all water, oil and gas formations.

OIL, GAS OR WATER RECORDS

CASING RECORD

| FORMATION | CONTENT | FROM | TO | SIZE   | PUT IN | PULLED OUT |
|-----------|---------|------|----|--------|--------|------------|
|           |         |      |    | 8-5/8  | 863    | none       |
|           |         |      |    | 5 1/8" | 3627   | 2353'      |
|           |         |      |    |        |        |            |
|           |         |      |    |        |        |            |

Describe in detail the manner in which the well was plugged, indicating where the mud fluid was placed and the method or methods used in introducing it into the hold. If cement or other plugs were used, state the character of same and depth placed, from          feet to          feet for each plug set.

Sanded to 3575' and ran 5 sacks cement. Loaded hole, shot pipe at 2836', 2735', 2635', 2529', 2429', 2333', pulled 97 joints. Set rock bridge from 600 to 575' and ran 8 yards ready mix.

PLUGGING COMPLETE.

RECEIVED  
STATE CORPORATION COMMISSION

FEB 25 1977

CONSERVATION DIVISION  
Wichita, Kansas

(If additional description is necessary, use BACK of this sheet)  
Name of Plugging Contractor KELSO CASING PULLING  
CHASE, KANSAS


STATE OF KANSAS COUNTY OF RICE, ss.  
R. DARRELL KELSO (employee of owner) or (owner or operator)

of the above-described well, being first duly sworn on oath, says: That I have knowledge of the facts, statements, and matters herein contained and the log of the above-described well as filed and that the same are true and correct. So help me God

(Signature) R. Darrell Kelso  
CHASE, KANSAS  
(Address)

SUBSCRIBED AND SWORN TO before me this 23 day of February, 19 77

My commission expires

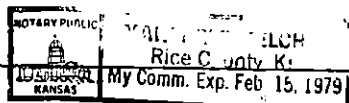

Margaret Melcher  
Notary Public.